

WELL PLUGGING RECORD

STATE OF KANSAS STATE CORPORATION COMMISSION


Give All Information Completely Make Required Affidavit Mail or Deliver Report to: Conservation Division State Corporation Commission 300 Bitting Building Wichita, Kansas

FORMATION PLUGGING RECORD

Strike out upper line when reporting plugging of formations.

Stafford County, Sec 15 Twp 22 Rge 15 (E) W (W) Location as "NE 1/4 NW 1/4 SW 1/4" or footage from lines NE-SW-SW

Lease Owner: PETROLEUM, Inc. Lease Name: Fruehauf Well No: 1 Office Address: 305 East Third Street, Wichita, Kansas Character of Well: Oil Date well completed: October 12 19 50 Application for plugging filed: April 22 19 53 Application for plugging approved: May 19 19 53 Plugging commenced: May 19 19 53 Plugging completed: May 23 19 53 Reason for abandonment: Depleted producible zones. If a producing well is abandoned, date of last production: April 21 19 53 Was permission obtained from the Conservation Division or its agents before plugging was commenced?: Yes

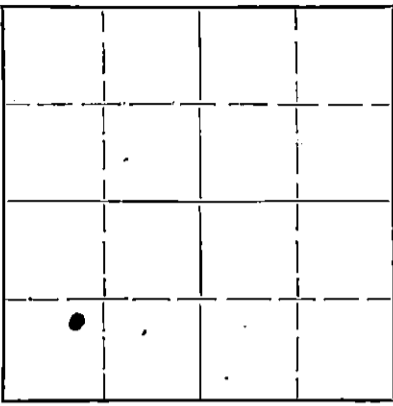

Locate well correctly on above Section Plat

Name of Conservation Agent who supervised plugging of this well: Merle Rives Producing formation: Kansas City Depth to top: 3,297' Bottom: ----- Total Depth of Well: 3,700' Feet Show depth and thickness of all water, oil and gas formations.

OIL, GAS OR WATER RECORDS CASING RECORD

Table with 7 columns: Formation, Content, From, To, Size, Put In, Pulled Out. Rows include Arbuckle (Water), Kansas City (Oil & Water), and Kansas City (Oil & Water).

Describe in detail the manner in which the well was plugged, indicating where the mud fluid was placed and the method or methods used in introducing it into the hole. If cement or other plugs were used, state the character of same and depth placed, from feet to feet for each plug set.

(Plugged back to 3,481') Filled hole back to 3,320' with crushed rock and dumped 5 sacks cement onto rock at 3,320'. Mudded up to 225' and placed rock bridge from 225' to 220'. Placed 20 sacks cement on top of rock bridge. Mudded up to 35' and placed rock bridge from 35' to 30'; filled hole to base of cellar with 5 sacks cement.

(If additional description is necessary, use BACK of this sheet) Correspondence regarding this well should be addressed to: PETROLEUM, Inc. Address: Rural Route 2, Great Bend, Kansas

STATE OF Kansas, COUNTY OF Sedgewick, ss. C. J. Wiltse (employee of owner) or (owner or operator) of the above-described well, being first duly sworn on oath, says: That I have knowledge of the facts, statements, and matters herein contained and the log of the above-described well as filed and that the same are true and correct. So help me God.

(Signature) [Signature] Rural Route 2, Great Bend, Kansas (Address)

SUBSCRIBED AND SWORN to before me this 6th day of June 19 53 [Signature] Notary Public.

My commission expires Oct 13, 1954

PLUGGING FILE SEC 15 T 22 R 120 BOOK PAGE 95 LINE 41

22-2625 2-48-15M

JUN 16 1953 6-16-53 CONSERVATION DIVISION Wichita, Kansas

WELL LOG FREUHAUF #1

Petroleum, Inc., Lease Owner

Section 15, Twp. 22S, Rge. 12W

Garvey Oil, Contractor

Location: NE SW SW

Rotary Total Depth: 3700'

County: Stafford, Kansas

Commenced: September 27, 1950

Elevation: 1859 D.F.

Completed: October 9, 1950

Casing: 218' of 8 5/8"
3699' of 5 1/2"

Figures below indicate bottom of formation:

	<u>Tops</u>	
60 Shale		
110 Sand		
140 Shale & Shells	3144	Heebner
645 Sand & Shale	3162	Toronto
958 Shale & Shells	3179	Base Oread
979 Anhydrite	3275	Br. Lime
1225 Shale & Shells	3297	Lansing
1370 Salt & Shale	3557	Viola
1820 Lime & Shale	3602	Simpson
2010 Br. Lime	3672	Arbuckle
2150 Lime & Shale		
3128 Lime	D.S.T. #1, 3322-45,	open 1 hour, closed 15 mins., rec. 60' heavily oil and gas cut mud.
3210 Lime & Shale	D.S.T. #2, 3347-80,	open 30 mins., closed 15 mins., rec. 10' mud with slight rainbow.
3275 Shale	D.S.T. #3, 3425-60,	open 1 hour, closed 15 mins., rec. 55' gas cut mud.
3295 Lime	D.S.T. #4, 3458-98,	open 1 hour, closed 15 mins., rec. 50' very slightly oil and gas cut mud.
3600 Viola Chert		
3625 Shale		
3695 Lime		
3700 R.T.D.		

I hereby certify that this is a true and correct log of the above mentioned well.

PETROLEUM, INC.

PLUGGING
 FILE SEC. 15 T. 22 R. 12W
 BOOK PAGE 95 LINE 41

By Eric H. Jager
Eric H. Jager

STATE OF KANSAS:
: SS.
SEDGWICK COUNTY:

Subscribed to and sworn to before me, a Notary Public, in said County and State this 11th day of October, 1950.

Marjorie Bradshaw
Notary Public

My commission expires: October 27, 1952