


STATE OF KANSAS  
STATE CORPORATION COMMISSION

WELL PLUGGING RECORD

Give All Information Completely  
Make Required Affidavit  
Mail or Deliver Report to:  
Conservation Division  
State Corporation Commission  
211 No. Broadway  
Wichita, Kansas

Finney County. Sec. 19 Twp 22S Rge. 31W (E) (W)  
Location as "NE/CNW%SW%" or footage from lines C/NW/4  
Lease Owner A.D. McKelvy  
Lease Name Trekell Well No. #2  
Office Address 48 Lloyd Drive - Atherton, Calif.  
Character of Well (completed as Oil, Gas or Dry Hole) dry hole  
Date well completed 4/21/58 19  
Application for plugging filed 4/20/58 19  
Application for plugging approved 4/20/58 19  
Plugging commenced 4/21/58 19  
Plugging completed 4/21/58 19  
Reason for abandonment of well or producing formation dry hole

NORTH

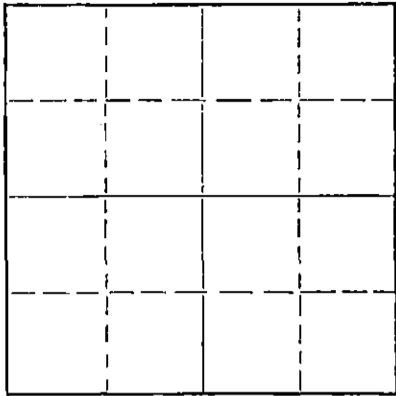

Locate well correctly on above  
Section Plat

If a producing well is abandoned, date of last production \_\_\_\_\_ 19  
Was permission obtained from the Conservation Division or its agents before plugging was commenced? yes

Name of Conservation Agent who supervised plugging of this well M.A. Rives, Garden City, Kansas  
Producing formation \_\_\_\_\_ Depth to top \_\_\_\_\_ Bottom \_\_\_\_\_ Total Depth of Well 2800 Feet  
Show depth and thickness of all water, oil and gas formations.

OIL, GAS OR WATER RECORDS

CASING RECORD

FORMATION	CONTENT	FROM	TO	SIZE	PUT IN	PULLED OUT
Shale & sand		0	346 <sup>±</sup>	8 5/8"	346	

Describe in detail the manner in which the well was plugged, indicating where the mud fluid was placed and the method or methods used in introducing it into the hole. If cement or other plugs were used, state the character of same and depth placed, from \_\_\_\_\_ feet to \_\_\_\_\_ feet for each plug set.

Plugged hole w/20 sx cement @325<sup>±</sup> thru D.P. 10sx @35<sup>±</sup>. Hole plugged w/heavy mud.

5-1-58

(If additional description is necessary, use BACK of this sheet)  
Name of Plugging Contractor Graham-Michaelis Drlg. Co.  
Address 211 North Broadway, Wichita, Kansas

STATE OF Kansas, COUNTY OF Sedgwick, ss.  
O.W. Woodland (employee of owner) or (~~owner or operator~~) of the above-described well, being first duly sworn on oath, says: That I have knowledge of the facts, statements, and matters herein contained and the log of the above-described well as filed and that the same are true and correct. So help me God. Graham-Michaelis Drlg. Co.

(Signature) O.W. Woodland  
211 North Broadway, Wichita, Ka.  
(Address)

SUBSCRIBED AND SWORN TO before me this 29th day of April, 19 58  
W.D. Gier  
Notary Public.

My commission expires 1-7-61

PLUGGING  
FIL SEC 19T.22 R314  
BOOK PAGE 96 LINE 15

WELL LOG BUREAU—KANSAS GEOLOGICAL SOCIETY  
508 East Murdock, Wichita, Kansas


COPY

Company- A. D. McKELVY  
Farm- Trekell No. 2

SEC. 19 T. 22 R. 31W  
C NW/4

Total Depth. 2800'  
Comm. 4-16-58 Comp. 4-21-58  
Shot or Treated.  
Contractor. Graham-Michaelis Drlg.  
Issued. 6-7-58

County Finney KANSAS

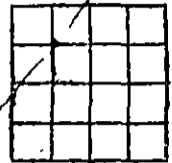

CASING:  
8 5/8" 346.72' cem w/175 sx.

Elevation. 2931' KB

Production. Dry

Figures Indicate Bottom of Formations.

shale & sand	1240
red bed	1540
shale & anhydrite	2353
shale & lime	2670
sand & shale	2800 RTD
Total Depth	

TOPS: SCOUT	
Herington	2678
Upper Krider	2705
Lower Krider	2731
Winfield	2761