

WELL PLUGGING RECORD


FORMATION PLUGGING RECORD

OR 15-009-06495-0000

Strike out upper line when reporting plugging off formations.

Give All Information Completely
Take Required Affidavit
Call or Deliver Report to:
Conservation Division
State Corporation Commission
800 Bittling Building
Wichita, Kansas

Barton County. Sec. 1 Twp. 16S Rge. (#) 12 (W)
Location as "NE $\frac{1}{4}$ NW $\frac{1}{4}$ SW $\frac{1}{4}$ " or footage from lines NE NE SW $\frac{1}{4}$
Lease Owner Bridgeport Oil Company, Inc.
Lease Name Schauf "B" Well No. 1
Office Address 918 Central Building - Wichita 2, Kansas
Character of Well (completed as Oil, Gas or Dry Hole) Dry hole
Date well completed 7 - 3 - 19 45
Application for plugging filed 7 - 3 - 19 45
Application for plugging approved 7 - 3 - 19 45
Plugging commenced 7 - 3 - 19 45
Plugging completed 7 - 3 - 19 45
Reason for abandonment of well or producing formation Dry hole
If a producing well is abandoned, date of last production 19
Was permission obtained from the Conservation Division or its agents before plugging was commenced? Yes

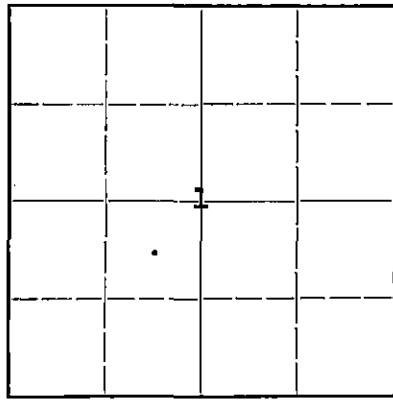

Locate well correctly on above Section Plat

Name of Conservation Agent who supervised plugging of this well Mr. H. W. Kerr - Great Bend, Kansas
Producing formation Depth to top Bottom Total Depth of Well 3379 Feet
Show depth and thickness of all water, oil and gas formations.

OIL, GAS OR WATER RECORDS

CASING RECORD

Formation	Content	From	To	Size	Put In	Pulled Out
				<u>8-5/8"</u>	<u>292'</u>	<u>None</u>

Describe in detail the manner in which the well was plugged, indicating where the mud fluid was placed and the method or methods used in introducing it into the hold. If cement or other plugs were used, state the character of same and depth placed, from feet to feet for each plug set.

Filled hole with mud from 3379' to 292'
Set plug at 292' with 15 sacks
Filled hole with mud to 35'
Set plug at 35' and cemented on top of plug with 10 sacks to within 6' of top

PLUGGING
FILE SEC. 1 TWP. 16S RGE. 12
BOOK PAGE 19 LINE 23

(If additional description is necessary, use BACK of this sheet)
Correspondence regarding this well should be addressed to Bridgeport Oil Company, Inc.
Address 918 Central Building - Wichita 2, Kansas.

STATE OF Kansas COUNTY OF Sedgwick, ss.
Frank Leach (employee of owner) or (owner or operator) of the above-described well,

being first duly sworn on oath, says: That I have knowledge of the facts, statements, and matters herein contained and the log of the above-described well as filed and that the same are true and correct. So help me God.

(Signature) Paul Leach
Wichita, Kansas
(Address)

SUBSCRIBED AND SWORN to before me this 13th day of July, 19 45

My commission expires April 13, 1949
Martha Loeffl
Notary Public.

BRIDGEPORT OIL COMPANY, INC.,
918 Central Building,
Wichita 2, Kansas.

Well Log-----Schauf "B" #1
NE NE SW $\frac{1}{4}$ 1-16S-12W
Barton County, Kansas

Elevation-----1883'
Date Started-----6-18-45
Date Completed----7-3-45

Casing Record:-
8-5/8" casing cemented @ 292'
with 150 sacks bulk cement.

Rotary Tools-----0 to 3379'

LOG	
0	160 Shale & Sand Stone
160	430 Shale & Lime Shells
430	440 Shale & Shells
440	450 Sand
450	695 Red Bed and Lime Shells
695	710 Shale & Shells
710	790 Lime & Shells
790	865 Shale & Shells
865	1056 Lime & Shale
1056	1145 Shale & Shells
1145	1390 Salt & Shale
1390	1425 Shale & Lime Shells
1425	1465 Shale & Shells
1465	1505 Lime
1505	1910 Lime & Shale
1910	2010 Lime
2010	2105 Lime & Shale
2105	2150 Shale
2150	2315 Lime & Shale
2315	2420 Shale & Shells
2420	2495 Lime & Shale
2495	2655 Shale & Shells
2655	2734 Lime & Shale
2734	2935 Lime
2935	3020 Lime Shells & Shale
3020	3295 Lime
3295	3320 Lime & Shale
3320	3379 Conglomerate
3379	T.D.

Plugged & Abandoned 7-3-45

FORMATION TOPS - DF	
Top Topeka	2673'
Top Heebner	2928'
Top Toronto	2945'
Base Oread	2960'
Top Brown Lime	3024'
Top Lansing	3034'
Top Conglomerate	3314'
Top Arbuckle	3352'

STATE OF KANSAS
RECORDS & COURTS
JUL 14 1945

I, Frank Leach, do hereby
certify that the above log
is correct to the best of my
knowledge and belief.

BRIDGEPORT OIL COMPANY, INC.

By: Frank Leach

PLUGGING
FILE - 1-16-12W
BOOK PAGE 19 LINE 23