

STATE OF KANSAS
STATE CORPORATION COMMISSION


Give All Information Completely
Make Required Affidavit
Mail or Deliver Report to:
Conservation Division
State Corporation Commission
211 No. Broadway
Wichita, Kansas

WELL PLUGGING RECORD

Rice County, Sec. 17 Twp. 20S Rge. 8 (E) W (W)

Location as "NE/CNWxSWx" or footage from lines C N/2 NE/4
Lease Owner Lebsack Oil Production, Inc.
Lease Name Tobias Well No. 1
Office Address Box 489, Hays, Kansas 67601
Character of Well (completed as Oil, Gas or Dry Hole) Dry Hole
Date well completed 9-13 19 67
Application for plugging filed 9-13 19 67
Application for plugging approved 9-13 19 67
Plugging commenced 9-13 19 67
Plugging completed 9-13 19 67
Reason for abandonment of well or producing formation Dry Hole

NORTH

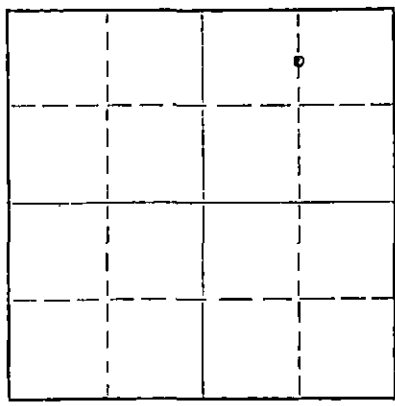

Locate well correctly on above
Section Plat

If a producing well is abandoned, date of last production 19
Was permission obtained from the Conservation Division or its agents before plugging was commenced? Yes

Name of Conservation Agent who supervised plugging of this well Gilbert Toman
Producing formation _____ Depth to top _____ Bottom _____ Total Depth of Well _____ Feet
Show depth and thickness of all water, oil and gas formations.

OIL, GAS OR WATER RECORDS

CASING RECORD

FORMATION	CONTENT	FROM	TO	SIZE	PUT IN	PULLED OUT
Surface Pipe		-0-	245	8 5/8"	245	-0-

Describe in detail the manner in which the well was plugged, indicating where the mud fluid was placed and the method or methods used in introducing it into the hole. If cement or other plugs were used, state the character of same and depth placed, from _____ feet to _____ feet for each plug set.

Filled hole with heavy mud.

#1 Plug @ 230' W/ 1/2 sk. hulls and 25 sks. cement

#2 Plug @ 40' W/ 1/2 sk. hulls and 10 sks. cement

#3 Plug in rat hole W/ 1/2 sk. hulls and 2 sks. cement

STATE CORPORATION COMMISSION
SEP 19 1967
CONSERVATION DIVISION
WICHITA, KANSAS
9-19-67


(If additional description is necessary, use BACK of this sheet)

Name of Plugging Contractor S & S Drilling Co.
Address Box 645, Great Bend, Kansas 67530

STATE OF Kansas, COUNTY OF Barton, ss.
T. D. Sweetman (employee of owner) or (owner or operator) of the above-described well, being first duly sworn on oath, says: That I have knowledge of the facts, statements, and matters herein contained and the log of the above-described well as filed and that the same are true and correct. So help me God.

(Signature) T. D. Sweetman
Box 645, Great Bend, Kansas 67530
(Address)

SUBSCRIBED AND SWORN to before me this 15th day of September, 19 67

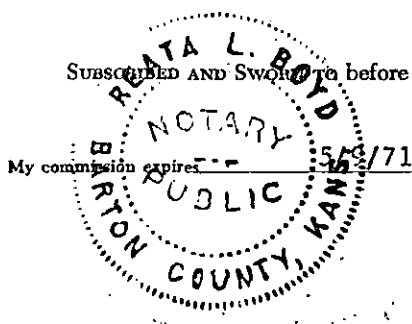

Leata L. Boyd
Notary Public.

WELL LOG
Tobias #1
C N/2 NE/4 17-20S-8W
Rice County, Kansas

<u>FROM</u>	<u>TO</u>		Elevation: 1659' DF
0	90	Sand	
90	165	Red Bed	
165	250	Shale & Anhy.	
250	1050	Shale	
1050	1550	Shale & Lime	
1550	1720	Shale	
1720	3125	Shale & Lime	
3125	3205	Lime	
3205	3290	Shale & Lime	
3290	3550	Lime	
3550		Total Depth	

RECEIVED
STATE CORPORATE COMMISSION
SEP 19 1967
CONSERVATION DIVISION
Topeka, Kansas

STATE OF KANSAS
COUNTY OF BARTON ss

T. D. Sweetman, Partner of S & S Drilling Company, being first duly sworn on oath says: That I have knowledge of the facts, statements and matters herein contained and the log of the above described well as filed and that the same are true and correct:

T. D. Sweetman

T. D. Sweetman

Subscribed and sworn before me this 15th day of September, 1967

Leata L. Boyd

Notary Public Barton County

My Commission Expires 5-9-71

