


STATE OF KANSAS
STATE CORPORATION COMMISSION

WELL PLUGGING RECORD

Give All Information Completely
Make Required Affidavit
Mail or Deliver Report to
Conservation Division
State Corporation Comm.
245 North Water
Wichita, KS 67202

Barton County, Sec. 2 Twp. 16 Rge. 12 E/W
Location as "NE/CNW $\frac{1}{4}$ SW $\frac{1}{4}$ " or footage from lines C-N/2-SE-SW

Lease Owner L. D. Davis
Lease Name Schauf Well No. 1
Office Address P. O. Box 324 Great Bend, Kans.
Character of Well (Completed as Oil, Gas or Dry Hole) 07530
dry hole

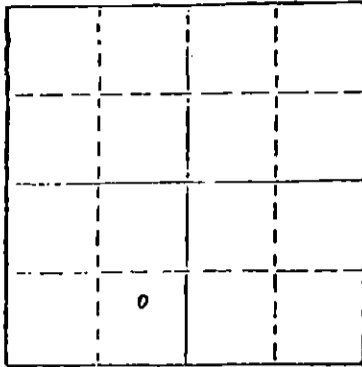

Locate well correctly on above
Section Plat

Date Well completed June 25 1980
Application for plugging filed June 25 1980
Application for plugging approved June 25 1980
Plugging commenced 4:30 P. M. June 25 1980
Plugging completed 5:30 P. M. June 25 1980
Reason for abandonment of well or producing formation _____

If a producing well is abandoned, date of last production _____
19 _____

Was permission obtained from the Conservation Division or
its agents before plugging was commenced? yes

Name of Conservation Agent who supervised plugging of this well Duane Rankin
Producing formation _____ Depth to top _____ Bottom _____ Total Depth of Well 3385'
Show depth and thickness of all water, oil and gas formations.

OIL, GAS OR WATER RECORDS

CASING RECORD

FORMATION	CONTENT	FROM	TO	SIZE	PUT IN	PULLED OUT

Describe in detail the manner in which the well was plugged, indicating where the mud fluid was placed and the method or methods used in introducing it into the hold. If cement or other plugs were used, state the character of same and depth placed, from _____ feet to _____ feet for each plug set.

50 sx. at 480' 50/50 Pozmix, 2% Gel
20 sx. at 300' " " " "
10 sx. at 40' " " " "
5 sx. at in rat hole

(If additional description is necessary, use BACK of this sheet)

Name of Plugging Contractor _____

STATE OF Kansas COUNTY OF Barton, ss.
Don Popp (employee of owner) or ~~(owner or operator)~~

of the above-described well, being first duly sworn on oath, says: That I have knowledge of the facts, statements, and matters herein contained and the log of the above-described well as filed and that the same are true and correct. So help me God.

(Signature) Don Popp
Susank, Kansas
(Address)

SUBSCRIBED AND SWORN TO before me this 26th day of June, 19 80

Bessie M. Dewerff
Bessie M. Dewerff Notary Public.

My commission expires 5-20-81

6-30-80

BESSIE M. DEWERFF
STATE NOTARY PUBLIC
BARTON COUNTY, KANSAS
MY APPT. EXP. 5-20-81

JUN 30 1980

Wichita, Kansas

DRILLERS WELL LOG

L. D. DRILLING, INC. - CONTRACTOR

L. D. DAVIS - OPERATOR

1 SCHAUF
C-N/2-SE-SW
Sec. 2-16S-12W
BARTON COUNTY, KANS.

T.D. 3385'
ELEV. 1885 K.B.

COMMENCED: 6-21-80
COMPLETED: 6-25-80

CASING: 8-5/8" set at 330'
CEMENT: 200 sx. 50/50 Pozmix, 2% Gel, 3% CC

<u>FORMATION</u>	<u>DEPTH</u>
Post Rock	0 - 65
Blue Shale	65 - 201
Red Bed	210 - 330
Shale & Shells	330 - 380
Sand	380 - 445
Shale & Shells	445 - 480
Red Bed	480-757
Anhy. Shale	757-783
Shale	783-2050
Shale W/Lime	2050-2400
Shale & Shells	2400-2763
Shale W/Lime	2763-2995
Lime & Shale	2995-3160
Lime	3161-3385
R.T.D.	3385

AFFIDAVIT

STATE OF KANSAS)
) ss
COUNTY OF BARTON)

I certify that this is a true and correct copy of the above log to the best of my knowledge.

L. D. DRILLING, INC.

L. D. Davis
L. D. Davis

Sworn to and subscribed before me this 27th day of June, 1980.

My appointment expires: 5-20-80

Bessie M. DeWerff
Bessie M. DeWerff, Notary Public

DESSIE M. DEWERFF
STATE NOTARY PUBLIC
BARTON COUNTY, KANSAS
MY APPT. EXP. 5-20-81

RECEIVED
STATE CORPORATION COMMISSION

JUN 30 1980