


WELL PLUGGING RECORD

Give All Information Completely
Make Required Affidavit
Mail or Deliver Report to:
Conservation Division
State Corporation Commission
211 No. Broadway
Wichita, Kansas

Barton County, Sec. 2 Twp. 16S Rge. 12W (H) (W)
Location as "NE/CNW/SW" or footage from lines SW NE SE
Lease Owner Herman George Kaiser, Oil Producer
Lease Name Schauf Well No. 6
Office Address 909 Palace Bldg., Tulsa, Oklahoma 74103
Character of Well (completed as Oil, Gas or Dry Hole) Dry Hole
Date well completed 10-5-64 19
Application for plugging filed 10-5-64 19
Application for plugging approved 10-5-64 19
Plugging commenced 10-5-64 19
Plugging completed 10-5-64 19
Reason for abandonment of well or producing formation Dry Hole

NORTH

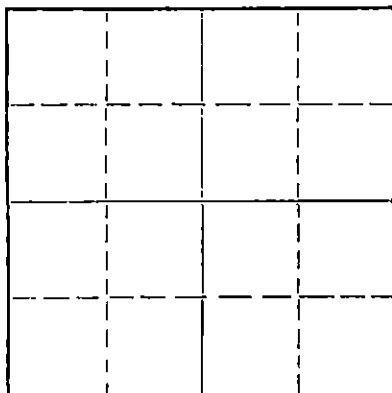

Locate well correctly on above
Section Plat

If a producing well is abandoned, date of last production _____ 19____
Was permission obtained from the Conservation Division or its agents before plugging was commenced? yes

Name of Conservation Agent who supervised plugging of this well Donald Truan, Russell, Kansas
Producing formation _____ Depth to top _____ Bottom _____ Total Depth of Well 3372 Feet
Show depth and thickness of all water, oil and gas formations.

OIL, GAS OR WATER RECORDS

CASING RECORD

| FORMATION | CONTENT | FROM | TO | SIZE | PUT IN | PULLED OUT |
|-----------|---------|------|----|--------|--------|------------|
| | | | | 8 5/8" | 313' | none |
| | | | | | | |
| | | | | | | |
| | | | | | | |
| | | | | | | |

Describe in detail the manner in which the well was plugged, indicating where the mud fluid was placed and the method or methods used in introducing it into the hole. If cement or other plugs were used, state the character of same and depth placed, from _____ feet to _____ feet for each plug set.

Mud to 300' Plug 1/2 sk. hulls 25 sks. cement through drill pipe
Mud to 40' 1/2 sk. hulls Plug 10 sks. cement to cellar base.
2 sks. in rathole.

RECEIVED
STATE CORPORATION COMMISSION
10-8-64
OCT 8 - 1964
CONSERVATION DIVISION
Wichita, Kansas

(If additional description is necessary, use BACK of this sheet)

Name of Plugging Contractor Leben Drilling, Inc.
Address Box 486, Great Bend, Kansas

STATE OF KANSAS, COUNTY OF BARTON, ss.
Leslie Kite (employee of owner) or (owner or operator) of the above-described well, being first duly sworn on oath, says: That I have knowledge of the facts, statements, and matters herein contained and the log of the above-described well as filed and that the same are true and correct. So help me God.

(Signature) Leslie Kite
Box 486, Great Bend, Kansas
(Address)

SUBSCRIBED AND SWORN TO before me this 7th day of October, 1964

My commission expires April 1, 1967
Ulanda Nichols Notary Public.

15-009-19156-00.00

DRILLER'S LOG

COMPANY: Herman George Kaiser, Oil Producer
 CONTRACTOR: LEBEN DRILLING, INC.
 FARM: SCHAUF #6
 LOCATION: SW NE SE Sec. 2-16S-12W
 BARTON COUNTY, KANSAS
 COMMENCED: 9-29-64
 COMPLETED: 10-5-64

| | | |
|------|-------------|---|
| 0 | 55 | Surface Clay & Post Rock |
| 55 | 313 | Shale |
| 313 | 410 | Shale & Redbed |
| 410 | 470 | Sand, Pyrite Iron |
| 470 | 485 | Shale & Redbed |
| 485 | 749 | Redbed |
| 749 | 782 | Anhydrite |
| 782 | 1175 | Red Shale & Shells |
| 1175 | 1700 | Shale & Shells |
| 1700 | 1780 | Shale with Lime Streaks |
| 1780 | 2015 | Lime & Shale |
| 2015 | 2195 | Lime |
| 2195 | 2690 | Lime & Shale |
| 2690 | 3372 | Lime |
| | <u>3372</u> | <u>Rotary Total Depth - D. & A.</u> |

RECEIVED
 STATE CORPORATION COMMISSION
 OCT 8 - 1964
 CONSERVATION DIVISION
 Wichita, Kansas

Set 8 5/8" used surface casing @ 313' with 175 sacks Sunset

I, Leslie Kite, do hereby certify that the above and foregoing is a true and correct copy of the log of the Schauf #6 well, located SW NE SE of Section 2, Township 16 South, Range 12 West, Barton County, Kansas, as reflected by the files of Leben Drilling, Inc.

Leslie Kite
 Leslie Kite

STATE OF KANSAS)
) SS
 COUNTY OF BARTON)

Subscribed and sworn to before me, a Notary Public, in and for Barton County, Kansas, this 7th day of October, 1964.

Ulanda Nichols
 Ulanda Nichols

My Commission Expires:
 April 1, 1967