

STATE OF KANSAS  
STATE CORPORATION COMMISSION

Give All Information Completely  
Make Required Affidavit  
Mail or Deliver Report to:  
Conservation Division  
State Corporation Commission  
800 Bittling Building  
Wichita, Kansas

OR  
FORMATION PLUGGING RECORD

Strike out upper line  
when reporting plug-  
ging off formations.

Barton County. Sec. 2 Twp. 16S Rge. 12 EXXX (W)

Location as "NE1/4NW1/4SW1/4" or footage from lines N 57 52

Lease Owner Arlington Bartlett Drilling Co., et al

Lease Name Schaefer No. 2 Well No. 2

Office Address 705 Petroleum Bldg., Wichita 2, Kansas

Character of Well (completed as Oil, Gas or Dry Hole) Dry Hole

Date well completed 3-24-49 19

Application for plugging filed 3-24-49 (verbal) 19

Application for plugging approved 3-24-49 (verbal) 19


Plugging commenced 3-24-49 19

Plugging completed 3-24-49 19

Reason for abandonment of well or producing formation dry hole

If a producing well is abandoned, date of last production 19

Was permission obtained from the Conservation Division or its agents before plugging was commenced? yes

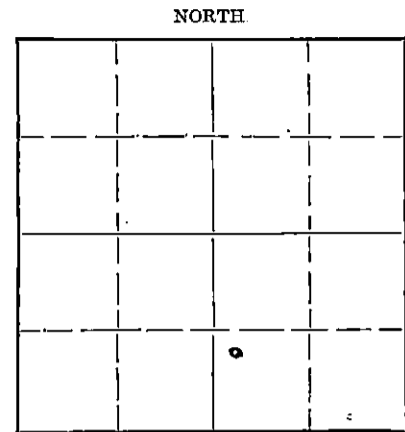

Locate well correctly on above  
Section Plat

Name of Conservation Agent who supervised plugging of this well C. D. Stough, Box 207, Great Bend, Kansas

Producing formation Depth to top Bottom Total Depth of Well 3367 Feet

Show depth and thickness of all water, oil and gas formations.

OIL, GAS OR WATER RECORDS

CASING RECORD

| Formation | Content | From | To | Size          | Put In                | Pulled Out  |
|-----------|---------|------|----|---------------|-----------------------|-------------|
|           |         |      |    | <u>8-5/8"</u> | <u>267'</u>           | <u>none</u> |
|           |         |      |    |               | <u>surface casing</u> |             |

Describe in detail the manner in which the well was plugged, indicating where the mud fluid was placed and the method or methods used in introducing it into the hole. If cement or other plugs were used, state the character of same and depth placed, from feet to feet for each plug set.

Set 267' of 8-5/8" casing cemented @ 264' with 130 sacks cement; 1 cc

*RECORDED*

3-26-49

STATE OF KANSAS  
CONSERVATION DIVISION  
WICHITA, KANSAS

(If additional description is necessary, use BACK of this sheet)

Correspondence regarding this well should be addressed to Arlington Bartlett Drilling Co.  
Address 705 Petroleum Bldg., Wichita 2, Kansas

STATE OF KANSAS COUNTY OF Ledgewick  
Richard Hendersy, one of the partners of Arlington Bartlett Drilling Co.  
(employee of owner) or (owner or operator) of the above-described well,

being first duly sworn on oath, says: That I have knowledge of the facts, statements, and matters herein contained and the log of the above-described well as filed and that the same are true and correct. So help me God.

(Signature) Richard Hendersy  
705 Petroleum Bldg., Wichita 2, Kansas

SUBSCRIBED AND SWORN to before me this 25th day of March, 19 49

November 29, 1950.

My commission expires

**PLUGGING**  
FILE REC 2-16-49  
88

SCHAUF "D" #2 - NW $\frac{1}{4}$  SW $\frac{1}{4}$  SE $\frac{1}{4}$  Sec. 2-16S-12W  
Barton County, Kansas

Date Started  
3-12-49

OPERATOR: Birmingham-Bartlett, et al

Date Completed  
3-23-49

CONTRACTOR: Birmingham-Bartlett Drilling Co.

Elevation: 1884 DF

SURFACE CASING: Ran 9 jts. - 267' of 8-5/8" casing  
cemented @ 264' with 130 sacks cement. lcc

OIL STRING: None. D & A

L O G

(Figures indicate bottom of formation)

|      |      |                  |
|------|------|------------------|
| 0 to | 140  | Surface Clay     |
|      | 264  | Shale & shells   |
|      | 275  | Shale            |
|      | 440  | Shale & shells   |
|      | 550  | Red bed & shells |
|      | 755  | Bed Rock         |
|      | 780  | Anhydrite        |
|      | 1430 | Shale & shells   |
|      | 2055 | Broken lime      |
|      | 2150 | Lime & shale     |
|      | 2650 | Shale & shells   |
|      | 2720 | Shale & lime     |
|      | 2995 | Lime             |
|      | 3055 | Shale            |
|      | 3060 | Brown Lime       |
|      | 3070 | Shale            |
|      | 3348 | Lime             |
|      | 3367 | Conglomerate     |
|      | 3367 | TOTAL DEPTH      |

The undersigned RICHARD HINDERY of the BIRMINGHAM-BARTLETT DRILLING CO. hereby certifies that the above log is a true and correct log of the formations encountered in drilling the above noted well as reflected by the daily drilling reports.

BIRMINGHAM-BARTLETT DRILLING CO.

BY Richard Hindery

Subscribed and sworn to before me this  
25th day of March, 1949.

Vivian L. Gager  
Notary Public

My commission expires November 29, 1950.

MAR 26 1949  
STATION

PLUGGING  
FILE SEC 2-16-12W  
BOOK PAGE 88 LINE 17