

WELL PLUGGING RECORD

STATE OF KANSAS CORPORATION COMMISSION


Give All Information Completely Make Required Affidavit Mail or Deliver Report to: Conservation Division State Corporation Commission 800 Blitting Building Wichita, Kansas

OR

FORMATION PLUGGING RECORD

Strike out upper line when reporting plugging of formations.

NORTH

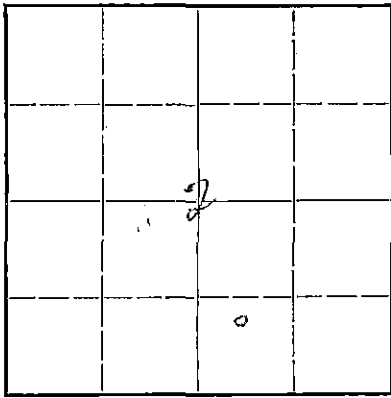

Locate well correctly on above Section Plat

Barton County. Sec. 2 Twp. 16 Rge. 12 (E) (W) Location as "NE 1/4 NW 1/4 SW 1/4" or footage from lines C of N 20 ac SW SE Lease Owner Winkler-Koch Engr. Co. Lease Name Schauf Well No. 1B Office Address 335 W. Lewis St., Wichita Ks. Character of Well (completed as Oil, Gas or Dry Hole) Oil Date well completed January 1944 Application for plugging filed March 19 1946 Application for plugging approved March 19 1946 Plugging commenced 3/22/46 19 Plugging completed 3/25/46 19 Reason for abandonment of well or producing formation Water encroachment If a producing well is abandoned, date of last production Oct. 10 1945 Was permission obtained from the Conservation Division or its agents before plugging was commenced? Yes

Name of Conservation Agent who supervised plugging of this well H. Kerr Producing formation Arbuckle Depth to top 3337' Bottom 3348' Total Depth of Well 3348 Feet Show depth and thickness of all water, oil and gas formations. 11'

OIL, GAS OR WATER RECORDS

CASING RECORD


Table with 7 columns: Formation, Content, From, To, Size, Put In, Pulled Out. Rows include Surface, Shale and gravel; Lime and Shale.

Describe in detail the manner in which the well was plugged, indicating where the mud fluid was placed and the method or methods used in introducing it into the hold. If cement or other plugs were used, state the character of same and depth placed, from... feet to... feet for each plug set.

5 1/2" casing set at 3337'. Dumped 5 sax cement on bottom. Top of cement 3312'. Heavy mud from 3312' to 270'. Set 12' rock bridge, dumped 15 sax cement. Filled with heavy mud to 15', dumped 10 sax for cap.

4-23-46

Handwritten notes: 2 16 12 W, 48-16

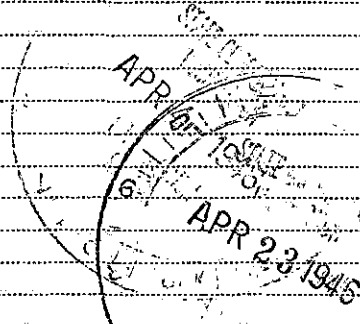

(If additional description is necessary, use BACK of this sheet)

Correspondence regarding this well should be addressed to Forbes & Miller Casing Pulling Co., Address Box 711, Great Bend, Kansas.

STATE OF Kans COUNTY OF Sedgewick V. E. Wiggins (employee of owner) or (owner or operator) of the above-described well, being first duly sworn on oath, says: That I have knowledge of the facts, statements, and matters herein contained and the log of the above-described well as filed and that the same are true and correct. So help me God.

(Signature) V. E. Wiggins

NOT NOTARIZED

SUBSCRIBED AND SWORN to before me this 10 day of April, 1946

H. C. Colgrove Notary Public

My commission expires Oct 28 1948

15-009-01347-00-00

COMPANY: Winkler-Koch Engineering Co.
CONTRACTOR: G. H. Hannum
FARM: Peter Schauf #1-B

LOCATION: C-N/20 - SW/40 -
SE/4 2-16-12
Barton County, Kansas

COMMENCED: December 18, 1943.
COMPLETED: December 29, 1943.

CASING RECORD:

274' - 8 5/8" cemented at
270' with 150 sax cement.

ELEVATION:
PRODUCTION:

3369' - 5 1/2" casing cemented at
3337 1/2' with 200 sax bulk cement -
2% aquagel - HOWC Co.

<u>Formation</u>	<u>Depth</u>
Shale & shells	4465'
Shale, shells & red rock	755'
Anhydrite	780'
Shale & shells	1270'
Salt	1140'
Shale & shells	1810'
Lime & shale breaks	2080'
Shale & shells	2650'
Shale	2762'
Lime	2930'
Lime & shale	3025'
Shale & shells	3074'
Lime - KC	3175'
Lime	3334'
Conglomerate	3337'
Arbuckle	3340'
TOTAL DEPTH	3348'

RECORDING
FILE 2-16-120
BOOK PAGE 48 LINE 16

