

STATE OF KANSAS
STATE CORPORATION COMMISSION

Give All Information Completely
Make Required Affidavit
Mail or Deliver Report to:
Conservation Division
State Corporation Commission
800 Bittling Building
Wichita, Kansas


OR
FORMATION PLUGGING RECORD

Strike out upper line
when reporting plugging
of formations.

Barton County, Sec. 2 Twp. 16 Rge. (E) 12(W)

Location as "NE $\frac{1}{4}$ NW $\frac{1}{4}$ SW $\frac{1}{4}$ " or footage from lines SW SW SW
Lease Owner The Globe Oil & Refining Co.-Ill. P.D.
Lease Name Schauf Well No. 1
Office Address 301 S. Market, Wichita, Kansas
Character of Well (completed as Oil, Gas or Dry Hole) Dry Hole
Date well completed November 14, 1945
Application for plugging filed November 14, 1945
Application for plugging approved November 14, 1945
Plugging commenced November 14, 1945
Plugging completed November 14, 1945
Reason for abandonment of well or producing formation Dry Hole

NORTH

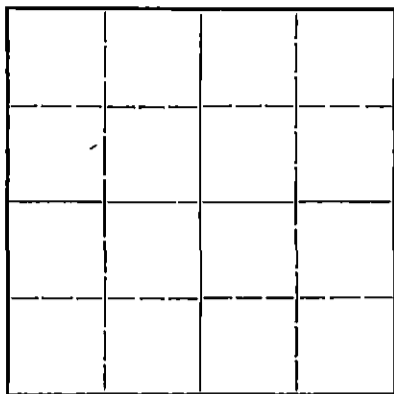

Locate well correctly on above
Section Plat

If a producing well is abandoned, date of last production 19...
Was permission obtained from the Conservation Division or its agents before plugging was commenced? Yes

Name of Conservation Agent who supervised plugging of this well Kerr
Producing formation Depth to top Bottom Total Depth of Well 3384 Feet
Show depth and thickness of all water, oil and gas formations.

OIL, GAS OR WATER RECORDS

CASING RECORD

Formation	Content	From	To	Size	Put In	Pulled Out
				8 5/8"	191'	None

Describe in detail the manner in which the well was plugged, indicating where the mud fluid was placed and the method or methods used in introducing it into the hole. If cement or other plugs were used, state the character of same and depth placed, from feet to feet for each plug set.

Filled hole with heavy mud to 185 feet, set wood plug with 20 sacks of cement, filled with mud, set wood plug with 15 sacks of cement on top to the surface.

APR 16 1949
4-16-49

(If additional description is necessary, use BACK of this sheet)

Correspondence regarding this well should be addressed to The Globe Oil & Refining Co.-Ill. P.D.
Address 301 South Market
Wichita, Kansas

STATE OF Kansas, COUNTY OF Sedgwick, ss.
Leo Ross (employee of owner) or (owner or operator) of the above-described well,
being first duly sworn on oath, says: That I have knowledge of the facts, statements, and matters herein contained and the log of the above-described well as filed and that the same are true and correct. So help me God.

(Signature) *Leo Ross*

(Address)

SUBSCRIBED AND SWORN to before me this 14th day of April, 1949.

Mercedes Dobbins
Notary Public.

My commission expires Dec 28, 1949.

PLUGGING
FILE SEC 2 T 16 R 12 W
BOOK PAGE 33 LINE 25

15-009-01168-00-00

COMPANY: Globe Oil & Refining - Illinois
CONTRACTOR: Ferrell-Young Drilling Co.
FARM: Peter Schauf #1

LOCATION: SWc SW/4 SW/4
Sec. 2-16S-12W,
Barton County, Kansas

COMMENCED: 11-4-45
COMPLETED: 11-14-45
ELEVATION: 1896

CASING RECORD:
8" 191' Cem. 90 sacks

<u>FORMATION</u>	<u>DEPTH</u>
Cellar	4
Shale, sand and shells	206
Shale, shells & red bed	765
Shale & shells	805
Anhydrite	830
Shale & shells	1225
Sale	1450
Shale, shells & lime streaks	1730
Lime & shale	2225
Shale & shells	2480
Shale & lime	2850
Lime broken	2935
Lime & shale	3150
Lime	3218
Broken lime	3310
Lime	3378
Cherty Conglomerate	3384
Total Depth	3384

TOPS:

Anhydrite	805
Brown Lime	3086
Lansing (White)	3099
Cherty Conglomerate	3363
Total Depth	3384
D & A	

PLUGGING
FILE SEC 2 T 16 R 12 W
BOOK PAGE 33 LINE 25

APR 16 1947