


Give All Information Completely  
Make Required Affidavit  
Mail or Deliver Report to:  
Conservation Division  
State Corporation Commission  
800 Bitting Building  
Wichita, Kansas

OR  
FORMATION PLUGGING RECORD

Strike out upper line  
when reporting plug-  
ging off formations.

NORTH

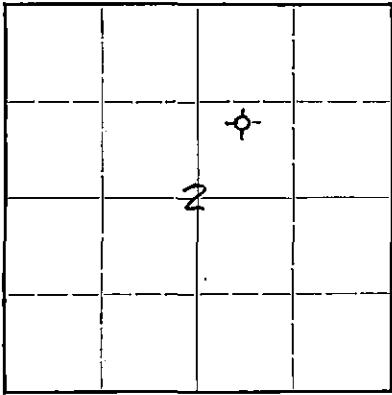

Locate well correctly on above  
Section Plat

Barton County. Sec. 2 Twp. 16 Rge. (E) 12 (W)  
Location as "NE $\frac{1}{4}$ NW $\frac{1}{4}$ SW $\frac{1}{4}$ " or footage from lines C. N/2 S.W. NE  
Lease Owner Fred C. Koch  
Lease Name Weber C Well No. 1  
Office Address 335 W. Lewis, Wichita, Kansas  
Character of Well (completed as Oil, Gas or Dry Hole) Dry Hole  
Date well completed 6/15 1945  
Application for plugging filed 6/15 1945  
Application for plugging approved 6/15 1945  
Plugging commenced 6/15 1945  
Plugging completed 6/15 1945  
Reason for abandonment of well or producing formation  
Well Dry  
If a producing well is abandoned, date of last production 19  
Was permission obtained from the Conservation Division or its agents before plugging was com-  
menced? Yes

Name of Conservation Agent who supervised plugging of this well Mr. W.H. Kerr, Great Bend, Kansas  
Producing formation..... Depth to top..... Bottom..... Total Depth of Well 334.6 Feet  
Show depth and thickness of all water, oil and gas formations.

OIL, GAS OR WATER RECORDS

CASING RECORD

Formation	Content	From	To	Size	Put In	Pulled Out
				8 5/8"	292'	None

Describe in detail the manner in which the well was plugged, indicating where the mud fluid was placed and the method or methods used in introducing it into the hold. If cement or other plugs were used, state the character of same and depth placed, from..... feet to..... feet for each plug set.

Gunned pits, circulated 1/2 hr. Layed down 1700' of Drill Pipe. Filled with heavy mud. Layed down rest of Drill Pipe. Filled hole with heavy mud to 290'. Drove wood plug to 290'. Pumped 15 sacks cement on top plug. Filled hole with heavy mud to 25'. Drove wood plug to 25' and poured 5 sacks cement on top this plug.

2 16 120  
16 39



6-19-45

(If additional description is necessary, use BACK of this sheet)

Correspondence regarding this well should be addressed to Donald T. Ingling  
Address 708 Fourth National Bank Bldg., Wichita, Kansas

STATE OF Kansas COUNTY OF Sedgwick, ss.  
I - W. W. Wright (employee of owner) or (owner or operator) of the above-described well,  
being first duly sworn on oath, says: That I have knowledge of the facts, statements, and matters herein contained and the log of the above-described well as filed and that the same are true and correct. So help me God.

(Signature) W. W. Wright  
708 Fourth Nat'l Bank Bldg  
(Address)

SUBSCRIBED AND SWORN to before me this 18th day of June 1945  
Leah V. Landrus Notary Public.

My commission expires April 10, 1948

15-009-01167-00-00

WELL LOG WEBER CI

Fred C. Koch - Lease Owner  
Donald T. Ingling - Contractor  
Total Depth: 3346'

Sec. 2, Twp. 16 Range 12W  
Location: C N/2 SW NE  
County: Barton (Kansas)

Commenced: May 26, 1945  
Completed: June 15, 1945

Elevation:

Casing: 292' of 8 5/8"

Production: Dry Hole

Figures below indicate bottom of formation:

60 Surface Soil & Rock  
120 Shale & Gravel Rock  
208 Shale  
225 Sand  
292 Shale & Lime Shells  
540 Shale & Iron Shells  
740 Redrock, Shale & Shells  
(Streaks of Iron)  
745 Shale  
770 Anhydrite  
985 Shale & Shells  
1280 Shale, Shells, Salt  
1365 Salt & Shale  
1485 Shale & Shells  
1585 Sdy. Lime


1665 Lime  
2000 Sdy. Lime & Shale  
2455 Lime & Shale  
2565 Shale & Shells  
2610 Lime & Shale  
2670 Shale & Shells  
2720 Shale & Lime  
3330 Lime  
3346 Lime & Shale  
3346 TOTAL DEPTH

I hereby certify that this is a true and correct log of the above mentioned well.

DONALD T. INGLING

STATE OF KANSAS)  
SEDGWICK COUNTY)

FILE  
16 120  
16 39  
ROCK  
SS.

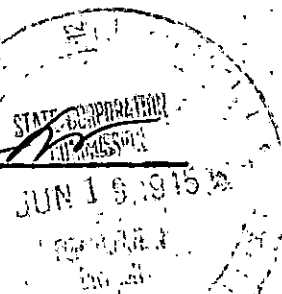

Subscribed and sworn to before me, a Notary Public in said County and State this 18th day of June, 1945.

*Leah V. Landrus*

My Commission expires: 4/10/48