

15-185-11733-0000

STATE OF KANSAS
STATE CORPORATION COMMISSION

WELL PLUGGING RECORD


FORMATION PLUGGING RECORD

Give All Information Completely
Make Required Affidavit
Mail or Deliver Report to:
Conservation Division
State Corporation Commission
800 Bittling Building
Wichita, Kansas

OR

Strike out upper line
when reporting plugging
off formations.

NORTH

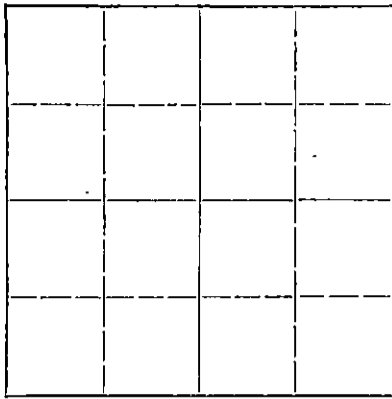

Locate well correctly on above
Section Plat

Stafford County. Sec. 28 Twp. 23S Rge. (E) 13(W)
Location as "NE $\frac{1}{4}$ NW $\frac{1}{4}$ SW $\frac{1}{4}$ " or footage from lines SE/4-SW/4-SE/4
Lease Owner Plains Exploration Company
Lease Name O'Connor Well No. 1
Office Address Denver, Colorado
Character of Well (completed as Oil, Gas or Dry Hole) Dry Hole
Date well completed 4-14-50 19.
Application for plugging filed 4-14-50 19.
Application for plugging approved 4-14-50 19.
Plugging commenced 4-14-50 19.
Plugging completed 4-14-50 19.
Reason for abandonment of well or producing formation Dry Hole

If a producing well is abandoned, date of last production 19.
Was permission obtained from the Conservation Division or its agents before plugging was commenced? yes

Name of Conservation Agent who supervised plugging of this well Mr. C. D. Stough
Producing formation Depth to top Bottom Total Depth of Well 4020 Feet
Show depth and thickness of all water, oil and gas formations.

OIL, GAS OR WATER RECORDS

CASING RECORD

Formation	Content	From	To	Size	Put In	Pulled Out
				8 5/8"	349'	None

Describe in detail the manner in which the well was plugged, indicating where the mud fluid was placed and the method or methods used in introducing it into the hold. If cement or other plugs were used, state the character of same and depth placed, from feet to feet for each plug set.

Hole filled with heavy mud and plug drove to 545'.
Mixed and poured 15 sks. of cement through drill pipe.
Filled hole to 40' below bottom cellar and drove plug to mud.
Filled hole to bottom of cellar with 11 sks. of cement.

4-20-50

(If additional description is necessary, use BACK of this sheet)

Correspondence regarding this well should be addressed to Plains Exploration Company
Address 524 University Building
Denver 2, Colorado

STATE OF Kansas, COUNTY OF Stafford, SS.
E. E. Duncan (employee of owner) or (owner or operator) of the above-described well,

being first duly sworn on oath, says: That I have knowledge of the facts, statements, and matters herein contained and the log of the above-described well as filed and that the same are true and correct. So help me God.

(Signature) E. E. Duncan


Stafford, Kansas (Address)

SUBSCRIBED AND SWORN to before me this 17 th day of April, 19 50

[Signature]

Notary Public.

My commission expires Aug 4, 1950

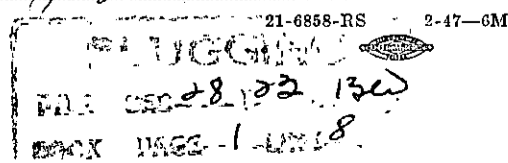

21-6858-RS 2-47-6M

PLAINS EXPLORATION COMPANY

DRILLERS WELL LOG

O'CONNOR #1

15-185-11733-0000

Company Plains Exploration Company
Farm O'Connor

Section 28T-23S-R13W
Location SE/4-SW/4-SE/4

Total Depth 4020'
Commenced March 30, 1950
Completed April 14, 1950
Shot or Treated No
Contractor E. K. Carey Drilling Company

County Stafford
Elevation 1903' K. B.
Production Dry Hole

CASING RECORD

8 5/8" set at 349' cemented with 225 sacks, by Halliburton.

All measurements carried from Kelly Bushing.

0' Kelly Bushing
10' Bottom Cellar
110' Sand
265' Shale
300' Sand
349' Shale
470' Red Bed
785' Shale
800' Anhydrite
1155' Shale
1790' Shale & Shells
2060' Lime
2455' Lime & Shale
3155' Shale & Lime
3365' Lime & Shale
3455' Lime
3502' Shale
3884' Lime
3897' Chert
5980' Cherty Lime
4005' Shale & Lime
4020' Lime
T. D.

Geologists Tops

Lansing	Kansas City	3528'
Base	Kansas City	3766'
Viola	?	3940'
Simpson		3985'
Arbuckle		4005'
Porosity	4010' - 4016'	
T. D.		4020'

No Shows Well Abandoned

I HEREBY CERTIFY THE ABOVE RECORD IS A TRUE AND CORRECT RECORD OF THE DRILLERS LOG ON THIS WELL.

E. E. Duncan

Subscribed and sworn to before me this 17 day of April 1950

My Commission expires July 4, 1950

[Signature]

PLUGGING
WELL SEC 28 23 21 30
BOOK PAGE 1 LIST 8