


WELL PLUGGING RECORD

Give All Information Completely
Make Required Affidavit
Mail or Deliver Report to:
Conservation Division
State Corporation Commission
800 Bittling Building
Wichita, Kansas

NORTH

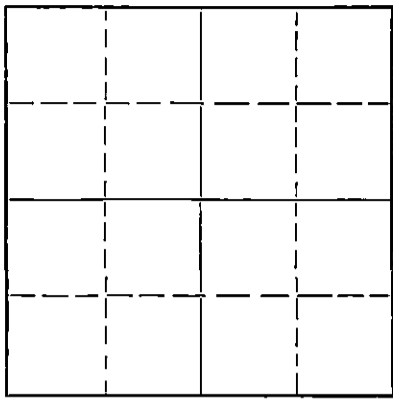

Locate well correctly on above Section Plat

Stafford County, Sec. 29 Twp. 23 Rge. (E) 13 (W)
Location as "NE/CNW/SW" or footage from lines NW/4 NE/4 NW/4
Lease Owner J. H. Johnson
Lease Name Budge Well No. 1
Office Address Kansas City, Missouri
Character of Well (completed as Oil, Gas or Dry Hole) Dry Hole
Date well completed March 4 19 53
Application for plugging filed March 4 19 53
Application for plugging approved March 4 19 53
Plugging commenced March 5 19 53
Plugging completed March 5 19 53
Reason for abandonment of well or producing formation Dry Hole

If a producing well is abandoned, date of last production 19
Was permission obtained from the Conservation Division or its agents before plugging was commenced? Yes

Name of Conservation Agent who supervised plugging of this well M. A. Rives, Pratt, Kansas
Producing formation Depth to top Bottom Total Depth of Well 3970 Feet
Show depth and thickness of all water, oil and gas formations.

OIL, GAS OR WATER RECORDS CASING RECORD

Formation	Content	From	To	Size	Put In	Pulled Out
				8 5/8	323	None
(Circulated top to bottom)						

Describe in detail the manner in which the well was plugged, indicating where the mud fluid was placed and the method or methods used in introducing it into the hole. If cement or other plugs were used, state the character of same and depth placed, from 3970 feet to 0 feet for each plug set.

Filled hole with heavy rotary mud to 300'
Set a plug of hulls at 300'
Placed 200 sacks of cement on top of plug.
Filled hole with heavy mud to 35'
Set a plug at 35'
Placed 1/2 sacks of hulls on top of plug.
Placed 10 sacks of cement on top of hulls to top of hole.

3-16-53

(If additional description is necessary, use BACK of this sheet)
Name of Plugging Contractor Stearns Drilling Company
Address Russell, Kansas

STATE OF KANSAS, COUNTY OF RUSSELL, ss.
O. G. Stearns (employee of owner) or (owner or operator) of the above-described well,
being first duly sworn on oath, says: That I have knowledge of the facts, statements, and matters herein contained and the log of the above-described well as filed and that the same are true and correct. So help me God.

(Signature) *O. G. Stearns*
Russell, Kansas (Address)

SUBSCRIBED AND SWORN to before me this 9th day of March, 19 53
Harold Arbuckle Notary Public.

My commission expires June 20, 1953

PLUGGING
FILE SEC 29 T 23 R 13 W
BOOK PAGE 22 LINE 22

