

WELL PLUGGING RECORD 15-185-11334-6500

Give All Information Completely
Make Required Affidavit
Mail or Deliver Report to:
Conservation Division
State Corporation Commission
211 No. Broadway
Wichita, Kansas

Stafford County, Sec. 30 Twp. 23 Rge. 13W (E) (W)

Location as "NE/CNW/SW" or footage from lines NW NW NW

Lease Owner A. L. ABERCROMBIE

Lease Name Smith Well No. 1

Office Address 801 Union Center, Wichita, Kansas

Character of Well (completed as Oil, Gas or Dry Hole) dry hole

Date well completed November 26 1963

Application for plugging filed November 27 1963

Application for plugging approved 19


Plugging commenced 8:30 p.m. 11-25-63 19

Plugging completed 12:15 a.m. 11-26-63 19

Reason for abandonment of well or producing formation dry hole

If a producing well is abandoned, date of last production 19

Was permission obtained from the Conservation Division or its agents before plugging was commenced? yes

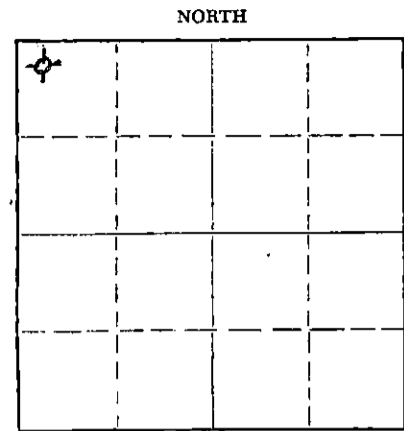

Locate well correctly on above Section Plat

Name of Conservation Agent who supervised plugging of this well Archie Elwing

Producing formation _____ Depth to top _____ Bottom _____ Total Depth of Well _____ Feet

Show depth and thickness of all water, oil and gas formations.

OIL, GAS OR WATER RECORDS

CASING RECORD

FORMATION	CONTENT	FROM	TO	SIZE	PUT IN	PULLED OUT
Surface casing	223'	0' 223'	223'	8 5/8"	223'	none

Describe in detail the manner in which the well was plugged, indicating where the mud fluid was placed and the method or methods used in introducing it into the hole. If cement or other plugs were used, state the character of same and depth placed, from _____ feet to _____ feet for each plug set.

Bottom plug at 250' with 1/4 sack hulls and 25 sax cement.
Topplug at 40' with 1/2 sack hulls and 10 sacks cement.
2 sax cement in rathole.

RECEIVED
STATE CORPORATION COMMISSION

DEC 2 1963

CONSERVATION DIVISION
Wichita, Kansas
12-2-63

(If additional description is necessary, use BACK of this sheet)

Name of Plugging Contractor Vaughan Drilling, Inc.

Address Box 825, Great Bend, Kansas

STATE OF KANSAS, COUNTY OF BARTON, ss.

DONALD D. VAUGHAN (XXXXXXXXXX) or (owner or operator) of the above-described well, being first duly sworn on oath, says: That I have knowledge of the facts, statements, and matters herein contained and the log of the above-described well as filed and that the same are true and correct. So help me God.

(Signature) Donald D. Vaughan

Donald D. Vaughan (Address)

SUBSCRIBED AND SWORN TO before me this 27th day of November, 1963

My commission expires Oct. 4, 1966

Kathryn M. Boxberger
Kathryn M. Boxberger Notary Public.

WELL LOG

15-185-11334-0000

COMPANY
CONTRACTOR
FARM
LOCATION

A. L. Abercrombie
Vaughan Drilling, Inc.
#1 Smith
NW NW of sec. 30-23-13W
Stafford County, Kansas

ELEVATION
SURFACE PIPE
PRODUCTION
COMMENCED
COMPLETION

1933' K. B.
8 5/8" cemented at 223' with 185 sax posmix
D & A
November 17, 1963
November 26, 1963

<u>FORMATION</u>	<u>DEPTH</u>
Sandstone	110
Shale	210
Red Bed	223
Shale & Red Bed	290
Sandstone	370
Red Bed	826
Anhydrite	844
Shale & Shells	1765
Limestone & Shale	3045
Limestone	3149
Limestone & Chalk	3275
Limestone	3450
Douglas Shale	3534
Limestone	3830

RECEIVED
STATE CORPORATION COMMISSION

DEC 2 1963

CONSERVATION DIVISION
Wichita, Kansas

FORMATION TOPS

Anhydrite	826 (+1107)
Heebner	3391 (-1458)
Douglas Shale	3428 (-1495)
Brown Lime	3533 (-1600)
Lansing	3548 (-1615)
RTD	3830 (-1897)

A F F I D A V I T

STATE OF KANSAS, COUNTY OF BARTON, SS

I, Donald D. Vaughan, of the VAUGHAN DRILLING, INC., being first duly sworn on oath, state; That I have knowledge of the facts, statements and matters herein contained and that the same are true and correct.

Donald D. Vaughan
Donald D. Vaughan

Subscribed and sworn to before me this 27th day of November, 1963.

Kathryn M. Boxberger
Kathryn M. Boxberger, Notary Public

MY Commission expires: Oct. 4, 1966.