

ORIGINAL COPY ~~CONFIDENTIAL~~ CONFIDENTIAL

SIDE ONE

**STATE CORPORATION COMMISSION OF KANSAS
OIL & GAS CONSERVATION DIVISION
WELL COMPLETION FORM
ACO-1 WELL HISTORY
DESCRIPTION OF WELL AND LEASE**

API NO. 15- 055-20,949-0000

County Finney

C SE NE Sec. 18 Twp. 22S Rge. 33 X East West

3300' Ft. North from Southeast Corner of Section

660' Ft. West from Southeast Corner of Section
(NOTE: Locate well in section plat below.)


Lease Name Garden City Well # 1-18

Field Name Unknown

Producing Formation Mississippian

Elevation: Ground 2894' KB 2899'

Total Depth 4830' PBDT

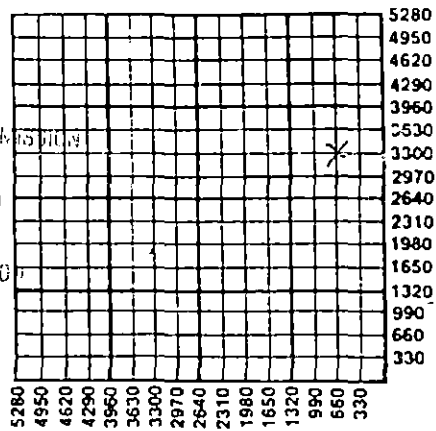

Amount of Surface Pipe Set and Cemented at 253 Feet

Multiple Stage Cementing Collar Used? X Yes No

If yes, show depth set 2026' Feet

If Alternate II completion, cement circulated from 2026'

feet depth to surface w/ 250 Thiessen H 125 15% ROI sx cmt.

Operator: License # 5210

Name: Lebsack Oil Production, Inc.

Address P.O. Box 489

City/State/Zip Hays, KS 67601

Purchaser: Koch

Operator Contact Person: Rex Curtis

Phone (913) 625-3046

Contractor: Name: Abercrombie Drilling, Inc.

License: 5422

Wellsite Geologist: Steve McClain/Wayne Lebsack

Designate Type of Completion

New Well Re-Entry Workover

Oil SWD Temp. Abd.

Gas Inj Delayed Comp.

Dry Other (Core, Water Supply, etc.)

If OWWO: old well info as follows:

Operator: N/A

Well Name: _____

Comp. Date _____ Old Total Depth _____

Drilling Method:

Mud Rotary Air Rotary Cable

12-11-90 12-21-90 1/7/91

Spud Date Date Reached TD Completion Date

INSTRUCTIONS: This form shall be completed in triplicate and filed with the Kansas Corporation Commission, 200 Colorado Derby Building, Wichita, Kansas 67202, within 120 days of the spud date of any well. Rule 82-3-130, 82-3-107 and 82-3-106 apply. Information on side two of this form will be held confidential for a period of 12 months if requested in writing and submitted with the form. See rule 82-3-107 for confidentiality in excess of 12 months. One copy of all wireline logs and drillers time log shall be attached with this form. ALL CEMENTING TICKETS MUST BE ATTACHED. Submit CP-4 form with all plugged wells. Submit CP-111 form with all temporarily abandoned wells. Any recompletion, workover or conversion of a well requires filing of ACO-2 within 120 days from commencement date of such work.

All requirements of the statutes, rules and regulations promulgated to regulate the oil and gas industry have been fully complied with and the statements herein are complete and correct to the best of my knowledge.

Signature [Signature]

Title Vice-President Date 2-28-91

Subscribed and sworn to before me this 28th day of February, 19 .

Notary Public [Signature]

Date Commission Expires _____

D. Rex Curtis
NOTARY PUBLIC
State of Kansas
My Appointment Expires 2-28-93

K.C.C. OFFICE USE ONLY		
F	<input checked="" type="checkbox"/>	Letter of Confidentiality Attached
C	<input checked="" type="checkbox"/>	Wireline Log Received
C	<input type="checkbox"/>	Drillers Timelog Received
Distribution		
<input checked="" type="checkbox"/>	KCC	<input type="checkbox"/> SWD/Rep <input type="checkbox"/> NGPA
<input type="checkbox"/>	KGS	<input type="checkbox"/> Plug <input type="checkbox"/> Other
(Specify)		