


STATE OF KANSAS  
STATE CORPORATION COMMISSION

WELL PLUGGING RECORD

Give All Information Completely  
Make Required Affidavit  
Mail or Deliver Report to:  
Conservation Division  
State Corporation Commission  
211 No. Broadway  
Wichita, Kansas

Stafford County, Sec. 1 Twp. 22S Rge. 13 ~~XXX~~ (W)  
Location as "NE/CNW/SW" or footage from lines 660' FEL and 330' ENL of SE 1/4  
Lease Owner Phillips Petroleum C N 1/2 NE SE  
Lease Name Millie Well No 1  
Office Address Box 779, Great Bend, Kansas  
Character of Well (completed as Oil, Gas or Dry Hole) Oil  
Date well completed 1-24-44 19\_\_  
Application for plugging filed 2-29-60 19\_\_  
Application for plugging approved 3-2-60 19\_\_  
Plugging commenced 3-9-60 19\_\_  
Plugging completed 3-22-60 19\_\_  
Reason for abandonment of well or producing formation Uneconomical to operate

NORTH

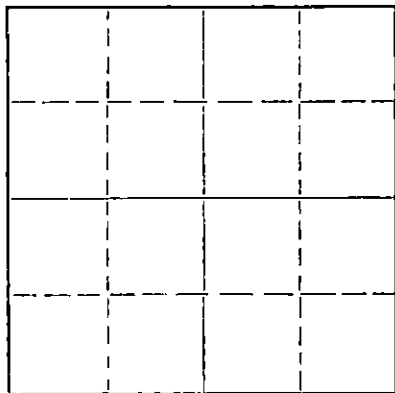

Locate well correctly on above  
Section Plat

If a producing well is abandoned, date of last production 3-3-60 19\_\_  
Was permission obtained from the Conservation Division or its agents before plugging was commenced? Yes

Name of Conservation Agent who supervised plugging of this well Mr. Frank Broadfoot  
Producing formation LKC Depth to top 3308 Bottom 3336 Total Depth of Well PB 3357 Feet  
Show depth and thickness of all water, oil and gas formations.

OIL, GAS OR WATER RECORDS

CASING RECORD

FORMATION	CONTENT	FROM	TO	SIZE	PUT IN	PULLED OUT
LKC		3309		8-5/8"	408.44	None
Arbuckle		3669		5 1/2"	3691.95'	1919'

Describe in detail the manner in which the well was plugged, indicating where the mud fluid was placed and the method or methods used in introducing it into the hole. If cement or other plugs were used, state the character of same and depth placed, from \_\_\_\_\_ feet to \_\_\_\_\_ feet for each plug set.

Mudded hole from 3357' to surface with 38 bbls. mud.  
Set rock bridge from 260' to 250'. Dumped 20 sx cement to 190'.  
Mudded hole to 40', set rock bridge to 30'. Dumped 10 sx cement  
to base of cellar.

STATE CORPORATION COMMISSION

MAR 24 1960  
CONSERVATION DIVISION  
WICHITA, KANSAS

3-24-60

(If additional description is necessary, use BACK of this sheet)  
Name of Plugging Contractor Knight Casing Pulling Company  
Address Great Bend, Kansas

STATE OF Kansas, COUNTY OF Barton, ss.  
A. J. Willis (employee of owner) or ~~conservator~~ of the above-described well, being first duly sworn on oath, says: That I have knowledge of the facts, statements, and matters herein contained and the log of the above-described well as filed and that the same are true and correct. So help me God.

(Signature) [Signature]  
(Address) \_\_\_\_\_

SUBSCRIBED AND SWORN TO before me this 22nd day of March, 19 60

My commission expires 11-18-61

[Signature]  
Notary Public.



EXPLORATION RECORDLease MillieWell 1

Formation Name	Top	Base	Remarks
Sand, gravel, red beds	0	365	
Red bed and shells	365	420	
Red bed, shale	420	973	
Shale and salt	973	1345	
Shale, lime, shells	1345	1645	
Sand, lime	1645	1772	
Lime and shale streaks	1772	1863	
Lime and shale	1863	1993	
Lime	1993	2184	
lime shale	2184	2431	
Shale, lime, shells	2431	2676	
Shale	2676	2922	
Lime and shale breaks	2922	3014	
Lime, shale, sand	3014	3095	
Lime and shale	3095	3164	
Shale	3164	3264	
Shale and lime	3264	3416	
Lime	3416	3555	
Chert	3555	3582	
Cherty lime and conglomerate	3582	3612	
Shale	3612	3669	
Dolomite lime	3669	3673	

EXPLORATION COMMISSION

MAR 24 1960

CONSERVATION DIVISION  
Wichita, Kansas

Top LKC 3309

Top Arbuckle 3669