
15-185-20838-0000

FORM CP-4

STATE OF KANSAS
STATE CORPORATION COMMISSION

WELL PLUGGING RECORD

Give All Information Completely
Make Required Affidavit
Mail or Deliver Report to
Conservation Division
State Corporation Comm.
245 North Water
Wichita, KS 67202

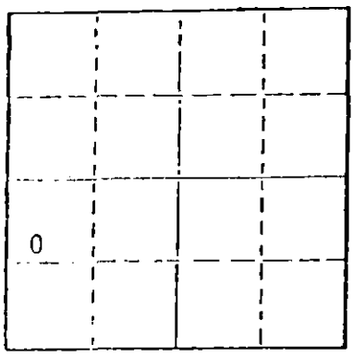

Locate well correctly on above Section Plat

Stafford County. Sec. 1 Twp. 22S Rge. 13 XE/W
Location as "NE/CNW¼SW¼" or footage from lines
NE NW SW
Lease Owner Lee Phillips Oil Company
Lease Name Love Well No. 1
Office Address Suite 1532-125 North Market, Wichita, Ks. 67202
Character of Well (Completed as Oil, Gas or Dry Hole)
Dry Hole
Date Well completed 7-16-78 19
Application for plugging filed 7-16-78 19
Application for plugging approved 7-16-78 19
Plugging commenced 7-16-78 19
Plugging completed 7-16-78 19
Reason for abandonment of well or producing formation
Dry Hole
If a producing well is abandoned, date of last production
N/A 19
Was permission obtained from the Conservation Division or its agents before plugging was commenced? Yes

Name of Conservation Agent who supervised plugging of this well Wm. T. Owen
Producing formation Depth to top Bottom Total Depth of Well 3420'
Show depth and thickness of all water, oil and gas formations.

OIL, GAS OR WATER RECORDS — CASING RECORD

FORMATION	CONTENT	FROM	TO	SIZE	PUT IN	PULLED OUT
Sand and Shale				8 5/8"	281'	None

Describe in detail the manner in which the well was plugged, indicating where the mud fluid was placed and the method or methods used in introducing it into the hold. If cement or other plugs were used, state the character of same and depth placed, from feet to feet for each plug set.

Plug 600' W/40Sx
270' W/40sx
Solid Brdg 40' W/12 Sx
Rathole W/3sx

50-50 PAZ

RECEIVED
STATE CORPORATION COMMISSION
JUL 24 1978
CONSERVATION DIVISION
Wichita, Kansas

(If additional description is necessary, use BACK of this sheet)
Name of Plugging Contractor Service Company

STATE OF Kansas COUNTY OF Sedgwick, ss.
Paul A. Seymour, Jr. (employee of owner) or (owner or operator) of the above-described well, being first duly sworn on oath, says: That I have knowledge of the facts, statements, and matters herein contained and the log of the above-described well as filed and that the same are true and correct. So help me God.

(Signature) Paul A. Seymour Jr
P. O. Box 8282, Munger Station
Wichita, Ks. (Address) 67208

SUBSCRIBED AND SWORN TO before me this 19th day of July, 1978

Ruth M. Bassett
Ruth M. Bassett Notary Public.

My commission expires May 30, 1979

15-185-20838-0000

BIG SPRINGS DRILLING, INC.

P.O. BOX 8287
MUNGER STATION
WICHITA, KANSAS 67208

SUITE 29 • 400 NORTH WOODLAWN • (316) 681-1732

July 19, 1978

DRILLERS LOG

Re: Lee Phillips Oil Company
Love # 1
NE NW SW
Sec. I Twp.22S Rg 13W
Stafford County, Kansas

OPERATOR: Lee Phillips Oil Company
CONTRACTOR: Big Springs Drilling, Inc.
COMMENCED: 7-11-78
COMPLETED: 7-16-78

Surface Pipe: 281' 8 5/8" W/275 Sx 60-40 PAZ 2% gel 3% ccl

0	281	Sand and Red Beds
281	708	Shale, Shells, Red Beds
708	732	Anhydrite
732	1596	Shale, Shell,Lime
1596	2385	Lime and Shale
2385	3300	Lime and Shale
3300	3420	Lime
3420		RTD

RECEIVED
STATE CORPORATION COMMISSION
JUL 24 1978
CONSERVATION DIVISION
Wichita, Kansas

We certify that the above and foregoing is a true and correct copy of the log on the # 1 Love located in Stafford County, Kansas.

BIG SPRINGS DRILLING, INC.

Paul A. Seymour, Jr.

Subscribed and sworn to before me this 19th day of July, 1978.

Ruth M. Bassett Notary Public

My Commission expires:
May 30, 1979