


STATE OF KANSAS  
STATE CORPORATION COMMISSION

WELL PLUGGING RECORD

Give All Information Completely  
Make Required Affidavit  
Mail or Deliver Report to:  
Conservation Division  
State Corporation Commission  
211 No. Broadway  
Wichita, Kansas

NORTH

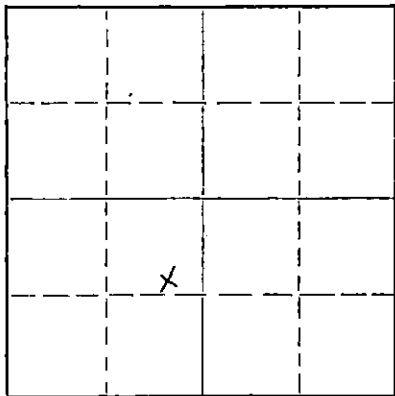

Locate well correctly on above  
Section Plat

Stafford County. Sec. 1 Twp. 22S Rge. 13W (~~22E~~) (~~13W~~)  
Location as "NE/CNW/SW" or footage from lines C SE NE SW  
Lease Owner Anschutz Oil Co., Inc.  
Lease Name Love Well No. 2  
Office Address 350 Denver Hilton Office Bldg., Denver, Colorado  
Character of Well (completed as Oil, Gas or Dry Hole) Dry hole  
Date well completed July 27 19 62  
Application for plugging filed August 7 19 62  
Application for plugging approved July 26 19 62  
Plugging commenced July 27 19 62  
Plugging completed July 27 19 62  
Reason for abandonment of well or producing formation Dry hole

If a producing well is abandoned, date of last production -- 19 --  
Was permission obtained from the Conservation Division or its agents before plugging was commenced? Yes

Name of Conservation Agent who supervised plugging of this well W. L. Lackamp  
Producing formation None Depth to top          Bottom          Total Depth of Well 3700 Feet  
Show depth and thickness of all water, oil and gas formations.

OIL, GAS OR WATER RECORDS

CASING RECORD

FORMATION	CONTENT	FROM	TO	SIZE	PUT IN	PULLED OUT
				8 5/8"	237	

Describe in detail the manner in which the well was plugged, indicating where the mud fluid was placed and the method or methods used in introducing it into the hole. If cement or other plugs were used, state the character of same and depth placed, from          feet to          feet for each plug set.

Plugged with 20 sacks cement at 200 feet and 10 sacks cement at 35 feet.

8-8-62

RECEIVED  
STATE CORPORATION COMMISSION

AUG 8 1962

CONSERVATION DIVISION  
Wichita, Kansas

(If additional description is necessary, use BACK of this sheet)

Name of Plugging Contractor S & S Drilling Company  
Address Box 339, Great Bend, Kansas

STATE OF Colorado, COUNTY OF Denver, ss.  
John D. Haley (employee of owner) or ~~owner or operator~~ of the above-described well, being first duly sworn on oath, says: That I have knowledge of the facts, statements, and matters herein contained and the log of the above-described well as filed and that the same are true and correct. So help me God.

(Signature) John D. Haley  
350 Denver Hilton Office Bldg., Denver, Colo.  
(Address)

SUBSCRIBED AND SWORN to before me this 7th day of August, 19 62

John E. Klump  
Notary Public.

My commission expires August 28, 1965



W E L L   L O G  
 Love # 2  
 Center SE NE SW    1-22-13  
Stafford County,        Kansas

<u>From</u>	<u>To</u>		<u>Elevation</u>	<u>1882 K.B.</u>
0	145	Sand & Red Bed	<u>Formation Tops:</u>	
145	237	Blue Shale		
237	1550	Shale, Shells & Salt	Heebner	3184'
1550	1760	Lime & Shale	Brown Lime	3317
1760	1940	Broken Shale	Kansas City	3334
1940	3345	Lime & Shale	Conglomerate	3606
3345'	3645	Lime	Viola	3618
3645	3680	Chert	Simpson	3686
3680	3700	Lime & Shale	T. D.	3700
3700		T.D.		1882
				<u>-1818</u>

STATE OF KANSAS

COUNTY OF BARTON ss

T. D. Sweetman, partner of S & S Drilling Company, being first duly sworn on oath says: That I have knowledge of the facts, statements and matters herein contained and the log of the above described well as filed and that the same are true and correct.

T. D. Sweetman

Subscribed and sworn before me this 31st day of July, 1962.

Jean Kimber  
 Notary Public        Barton County

My Commission expires Dec. 3, 1963.

**RECEIVED**  
 STATE CORPORATION COMMISSION

JUL 29 1962

CONSERVATION DIVISION  
 Wichita, Kansas