

STATE OF KANSAS  
STATE CORPORATION COMMISSION


WELL PLUGGING RECORD

Give All Information Completely  
Make Required Affidavit  
Mail or Deliver Report to:  
Conservation Division  
State Corporation Commission  
800 Bitting Building  
Wichita, Kansas

OR  
FORMATION PLUGGING RECORD

Strike out upper line  
when reporting plug-  
ging off formations.

NORTH

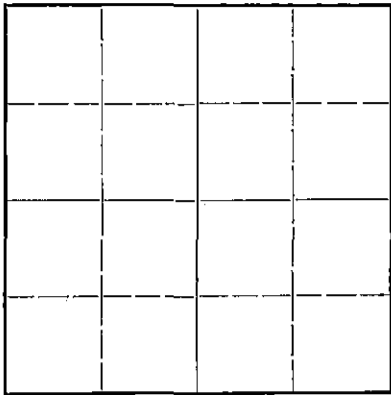

Locate well correctly on above  
Section Plat

Stafford County. Sec. 1 Twp. 22 Rge. (E) 13 (W)  
Location as "NE $\frac{1}{4}$ NW $\frac{1}{4}$ SW $\frac{1}{4}$ " or footage from lines. NE/4  
Lease Owner. Phillips Petroleum Co.  
Lease Name. Jilka Well No. 1  
Office Address. Bartlesville, Okla.  
Character of Well (completed as Oil, Gas or Dry Hole) Dry hole  
Date well completed. July 2, 1944 19.  
Application for plugging filed July 3, 1944 19.  
Application for plugging approved July 3, 1944 19.  
Plugging commenced. July 3, 1944 19.  
Plugging completed. July 3, 1944 19.  
Reason for abandonment of well or producing formation Dry hole

If a producing well is abandoned, date of last production 19.  
Was permission obtained from the Conservation Division or its agents before plugging was com-  
menced? Yes

Name of Conservation Agent who supervised plugging of this well Eldon Petty  
Producing formation Arbuckle Lime Depth to top. 3676 DF Bottom. 3680 DF Total Depth of Well. 3680 DF Feet  
Show depth and thickness of all water, oil and gas formations.


OIL, GAS OR WATER RECORDS

CASING RECORD

Formation	Content	From	To	Size	Put In	Pulled Out
Lensing Kansas City	Dry	3317'		8 5/8"	403' (L.O.T.)	None
Arbuckle (Took D.S. test)	Dry	3676'	3680			

Describe in detail the manner in which the well was plugged, indicating where the mud fluid was placed and the method or methods used in introducing it into the hold. If cement or other plugs were used, state the character of same and depth placed, from \_\_\_\_\_ feet to \_\_\_\_\_ feet for each plug set.

Filled with heavy mud to 411, set plug @ 411 and dumped 15 sacks cement. Filled with mud to 30', set plug & dumped 10 sacks cement, filling to base of cellar.

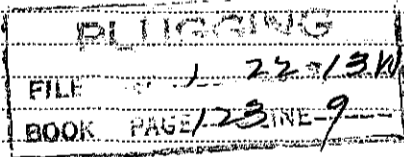

(If additional description is necessary, use BACK of this sheet)

Correspondence regarding this well should be addressed to F. W. Shelton  
Address Box 779 Great Bend, Kansas

STATE OF Kansas, COUNTY OF Barton, ss. 7-7-44  
F. W. Shelton (employee of owner) or (owner or operator) of the above-described well,  
being first duly sworn on oath, says: That I have knowledge of the facts, statements, and matters herein contained and the log of the above-described well as filed and that the same are true and correct. So help me God.

(Signature)

Box 779 Great Bend, Kans.  
(Address)

SUBSCRIBED AND SWORN to before me this 6th day of July, 19 44

My commission expires January 20, 1945

Notary Public.



