


STATE OF KANSAS  
STATE CORPORATION COMMISSION

Form CP-4

WELL PLUGGING RECORD

Give All Information Completely  
Make Required Affidavit  
Mail or Deliver Report to:  
Conservation Division  
State Corporation Commission  
212 No. Market  
Wichita, Kansas

NORTH

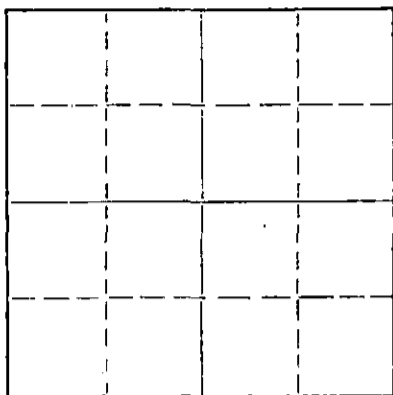

Locate well correctly on above  
Section Plat

Stafford County. Sec. 1 Twp 22S Rge. 13W (E) (W)  
Location as "NE/CNW/SW" or footage from lines SE/4 (SW NE SE)  
Lease Owner Robert L. Austin  
Lease Name Love Well No. 3  
Office Address P. O. Box 159, Stafford, Kansas 67578  
Character of Well (completed as Oil, Gas or Dry Hole) Oil  
Date well completed 6/21/62 19\_\_  
Application for plugging filed Yes 19\_\_  
Application for plugging approved Yes 19\_\_  
Plugging commenced 11/13/70 19\_\_  
Plugging completed 11/18/70 19\_\_  
Reason for abandonment of well or producing formation Uneconomical

If a producing well is abandoned, date of last production 6/29/70 19\_\_  
Was permission obtained from the Conservation Division or its agents before plugging was commenced? Yes

Name of Conservation Agent who supervised plugging of this well Russel Beberstein  
Producing formation \_\_\_\_\_ Depth to top \_\_\_\_\_ Bottom \_\_\_\_\_ Total Depth of Well 3745 Feet  
Show depth and thickness of all water, oil and gas formations.

OIL, GAS OR WATER RECORDS

CASING RECORD

FORMATION	CONTENT	FROM	TO	SIZE	PUT IN	PULLED OUT

Describe in detail the manner in which the well was plugged, indicating where the mud fluid was placed and the method or methods used in introducing it into the hole. If cement or other plugs were used, state the character of same and depth placed, from \_\_\_\_\_ feet to \_\_\_\_\_ feet for each plug set.

Mud from 3255' to 230'. Rock bridge from 230' to 220'. 6 yards of ready mix cement from 220' to base of cellar. Recovered 1680'.

12-8-70

RECEIVED  
STATE CORPORATION COMMISSION  
DEC 8 - 1970  
CONSERVATION DIVISION  
Wichita, Kansas

(If additional description is necessary, use BACK of this sheet)  
Name of Plugging Contractor Glenn & Smith Pipe Pulling Co.  
Address P. O. Box 156, Ellinwood, Kansas 67526

STATE OF Kansas, COUNTY OF Stafford, ss.  
Robert L. Austin (employee of owner) or (owner or operator) of the above-described well, being first duly sworn on oath, says: That I have knowledge of the facts, statements, and matters herein contained and the log of the above-described well, as filed and that the same are true and correct. So help me God.

(Signature) [Signature]  
P. O. Box 159, Stafford, Kansas 67578  
(Address)

Subscribed and sworn to before me this 4 day of December, 19 70  
My commission expires 1/28/73  
Irene L. Benton Notary Public.

