

STATE OF KANSAS  
STATE CORPORATION COMMISSION

Form CP-4

WELL PLUGGING RECORD

Give All Information Completely  
Make Required Affidavit  
Mail or Deliver Report to:  
Conservation Division  
State Corporation Commission  
212 No. Market  
Wichita, Kansas

Stafford County, Sec. 1 Twp. 22 Rge. 13 (E) W (W)

Location as "NE/CNWxSWx" or footage from lines SE NW NE

Lease Owner Bill Hay Drilling Co., Inc.

Lease Name Weizsbrod Well No. #1

Office Address 2007 Polk Great Bend, Kansas 67530

Character of Well (completed as Oil, Gas or Dry Hole)

Date well completed 19

Application for plugging filed August 19 69

Application for plugging approved August 19 69


Plugging commenced September 17 19 69

Plugging completed September 20 19 69

Reason for abandonment of well or producing formation

If a producing well is abandoned, date of last production 19

Was permission obtained from the Conservation Division or its agents before plugging was commenced? Yes

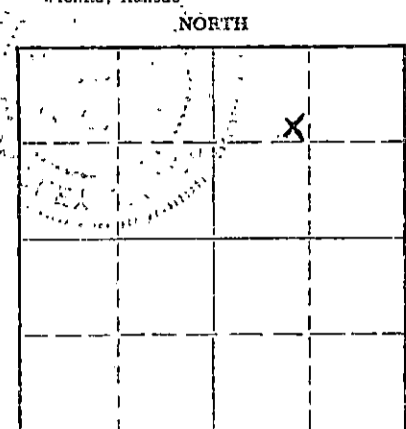

Locate well correctly on above Section Plat

Name of Conservation Agent who supervised plugging of this well Ralph Warren

Producing formation Depth to top Bottom Total Depth of Well Feet

Show depth and thickness of all water, oil and gas formations.

OIL, GAS OR WATER RECORDS

CASING RECORD

| FORMATION | CONTENT | FROM | TO | SIZE  | PWT IN | PULLED OUT |
|-----------|---------|------|----|-------|--------|------------|
|           |         |      |    | 8 5/8 | 254    | None       |
|           |         |      |    | 5 1/2 | 3680   | 2828       |
|           |         |      |    |       |        |            |
|           |         |      |    |       |        |            |
Describe in detail the manner in which the well was plugged, indicating where the mud fluid was placed and the method or methods used in introducing it into the hole. If cement or other plugs were used, state the character of same and depth placed, from feet to feet for each plug set.

September 17, 1969 Dumped sand to 3300'. Mixed and dumped 5 sx of cement to 3260'.

September 20, 1969 Set 10' rock bridge from 250' to 240'. Mixed and dumped 25 sx of cement. Mudded casing to 40'. Set 10' rock bridge from 40' to 30'. Mixed and dumped 10 sx of cement from 30' to base of cellar.

RECEIVED  
STATE CORPORATION COMMISSION

SEP 30 1969

CONSERVATION DIVISION  
Wichita, Kansas

9-30-69

Name of Plugging Contractor Russ Casing Pulling, Inc.  
Address P. O. Box 1082 Great Bend, Kansas 67530

STATE OF Kansas, COUNTY OF Barton, ss.  
E. L. Browning (employee or owner) or (owner or operator) of the above-described well, being first duly sworn on oath, says: That I have knowledge of the facts, statements, and matters herein contained and the log of the above-described well as filed and that the same are true and correct. So help me God.


(Signature) E. L. Browning

(Address)

Subscribed and sworn to before me this 29 day of September, 1969

October 8, 1972

Notary Public.

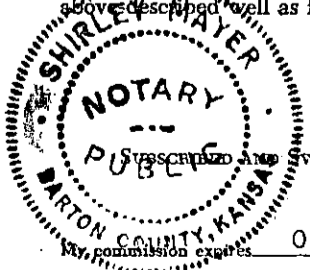

GEORGE A. McCALEB  
 Consulting Geologist  
 1433 Wichita Plaza  
 Office Phone FO 3-4402  
 Wichita, Kansas 67202

April 19, 1966

GEOLOGICAL REPORT

Lee Phillips Oil Co.  
 Graves Drlg. Co., Inc.  
 No. 1 Weizbrod  
 SE NW NE Sec. 1-22S-13W  
 Stafford County, Kansas

Contractor: Graves Drlg. Co., Inc.  
 Commenced: 4- 9-66  
 Completed: 4-15-66 (Rotary)  
 Cores: None  
 Electric Logs: None  
 Drill Stem Tests: Two  
 Samples: Examined and saved from  
 3000' to 3685' RTD

ELEVATIONS:

1878' KB  
 1876' DF  
 1873' GR

CASING RECORD:

8 5/8" @ 254'/275 sacks  
 5 1/2" @ 3680'/75 sacks

FORMATION TOPS  
 (Kelly Bushing Elevation)

|                     |              |
|---------------------|--------------|
| Heebner             | 3186 (-1308) |
| Toronto             | 3209 (-1331) |
| Douglas             | 3221 (-1343) |
| Brown Lime          | 3319 (-1441) |
| Lansing-Kansas City | 3336 (-1458) |
| Base Kansas City    | 3559 (-1681) |
| Viola               | 3591 (-1713) |
| Simpson Shale       | 3643 (-1765) |
| Simpson Sand        | 3653 (-1775) |
| Arbuckle            | 3676 (-1798) |
| Rotary Total Depth  | 3685 (-1807) |

RECEIVED  
 STATE CORPORATION COMMISSION  
 AUG 13 1969  
 CONSERVATION DIVISION  
 Wichita, Kansas