


STATE OF KANSAS  
STATE CORPORATION COMMISSION  
All Information Completely  
State Required Affidavit  
Call or Deliver Report to:  
Conservation Division  
State Corporation Commission  
800 Bitting Building  
Wichita, Kansas

### WELL PLUGGING RECORD

Harvey Co County, Sec 30 Twp 22 Rge 3 (E) (W)

Location as "NE/CNW $\frac{1}{4}$ SW $\frac{1}{4}$ " or footage from lines NE NW  
Lease Owner Brunson Drlg Co  
Lease Name Frantz  
Office Address 333 First Nat'l Bank Bld, Wichita, Kansas Well No. 1  
Character of Well (completed as Oil, Gas or Dry Hole) Dry Hole  
Date well completed 5/31/50  
Application for plugging filed 19  
Application for plugging approved 19  
Plugging commenced 5/25/50 19  
Plugging completed 5/31/50 19  
Reason for abandonment of well or producing formation  
If a producing well is abandoned, date of last production 19  
Was permission obtained from the Conservation Division or its agents before plugging was commenced? yes

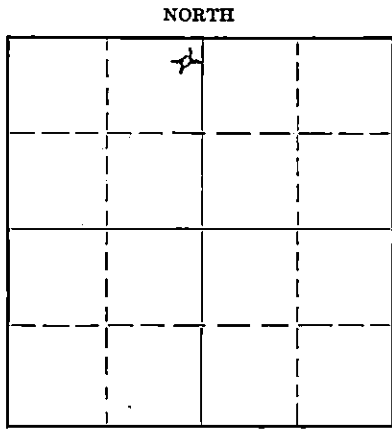

Locate well correctly on above Section Plat

Name of Conservation Agent who supervised plugging of this well  
Producing formation Depth to top Bottom Total Depth of Well Feet  
Show depth and thickness of all water, oil and gas formations.

#### OIL, GAS OR WATER RECORDS CASING RECORD

Formation	Content	From	To	Size	Put In	Pulled Out
				8 5/8	297	
				5 1/2	3540	2119' 4"

Describe in detail the manner in which the well was plugged, indicating where the mud fluid was placed and the method or methods used in introducing it into the hole. If cement or other plugs were used, state the character of same and depth placed, from feet to feet for each plug set.

Mudded hole from 3300 to 2500. Set rock bridge to 2490.  
Run 6 sks cement. Set rock bridge at 230. Run 15 sks cement.  
Mudded hole to 30. Run 10 sks cement.  
Well complete.

6-10-50  
RECORDED & INDEXED

(If additional description is necessary, use BACK of this sheet)  
Correspondence regarding this well should be addressed to Brunson Drlg Co JUN 10 1950  
Address same as above

STATE OF Kansas COUNTY OF Sedgewick, ss.  
Ralph B. McLaughlin (employee of owner) or (owner or operator) of the above-described well,  
being first duly sworn on oath, says: That I have knowledge of the facts, statements, and matters herein contained and the log of the above-described well as filed and that the same are true and correct. So help me God

(Signature) Ralph B. McLaughlin  
333 1st National Bank Bldg (Address)

SUBSCRIBED AND SWORN to before me this 9th day of June, 1950  
Edwin C. Cornbe Notary Public.

My commission expires September 23, 1953 22-7877-s 4-40-10M

**PLUGGING**  
FILE SEC 30 T 22 R 30  
BOOK PAGE 2 LINE 37

BRUNSON DRILLING COMPANY, INC. et al

Well: Frantz #1

NW NE NW Sec. 30-22-3W  
Harvey County, Kansas

Commenced RD: 2/11/50  
Completed RD: 2/23/50  
Total Depth: 3540'

Elevation: 1448' R.B.  
Initial Prod:  
Contractor: Brunson Drilling Co., Inc.

Commenced CD: 2/28/50  
Completed CD: 3/5/50  
Total Depth: 3580'

Casing: 297' 8 3/8" O.D. 8rd thd 2 1/2#  
3540' 5 1/2" O.D. 8rd thd 1 1/2#

STRATA	DEPTH
Surface soil & clay	30
Sand, Gravel & shells	230
Sand & shells	246
Shale & shells	480
Lime & shells	585
Lime & shale	960
Lime	1050
Shale & lime	1150
Lime & shale	1275
Shale & lime	1835
Broken Lime	1975
Lime	2005
Shale & lime	2285
Shale & sand	2365
Shale & lime	2660
Lime & shale	2740
Shale & lime	2790
Broken Lime	2864
Lime & shale	3007
Lime	3120
Chirt	3182
Lime & chirt	3205
Shale	3251
Lime	3307
Shale	3328
Lime	3405
Lime & shale	3460
Shale	3505
Lime & chirt	3519
Shale	3540
Sand	3576
Lime	3580
Total Depth	3580

TOPS:

Lansing K. C.	2487'
Mississippi	3138'
Kinderhook	3219'
Misener Sand	3324'
Hunton	3328'
Maquoketa	3407'
Viola	3461'
Simpson	3485'


I hereby certify the above is a true and correct log of said well as reflected by the daily drilling reports.

BRUNSON DRILLING COMPANY, INC.  
By

JUN 10 1950

STATE CORPORATION  
*William S. Brunson*  
Wm. S. Brunson KANSAS Sec.

Signed and sworn to in my presence this 10th day of April, 1950, by Wm. S. Brunson, secretary of the Brunson Drilling Company, Inc., a corporation in the State of Kansas.

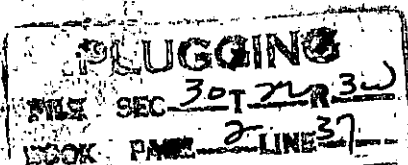

*Edwina C. Corales*  
Notary Public

My commission expires September 23, 1953.