

STATE OF KANSAS
STATE CORPORATION COMMISSION


WELL PLUGGING RECORD

Give All Information Completely
Make Required Affidavit
Mail or Deliver Report to:
Conservation Division
State Corporation Commission
800 Biting Building
Wichita, Kansas

~~FORMATION PLUGGING RECORD~~

Strike out upper line
when reporting plug-
ging off formations.

NORTH

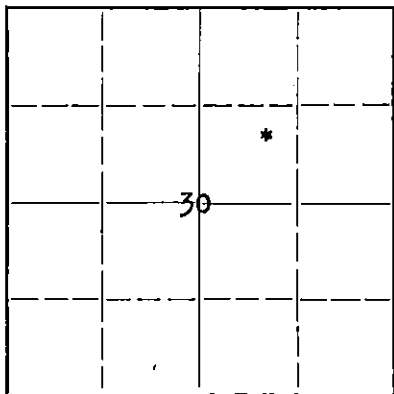

Locate well correctly on above
Section Plat

Harvey County, Sec. 30 Twp. 22S Rge. (E) 4 (W)
Location as "NE 1/4 NW 1/4 SW 1/4" or footage from lines NE SW NE
Lease Owner Magnolia Petroleum Company
Lease Name Katie Schmidt Well No. 7
Office Address Box 888, Ellinwood, Kansas
Character of Well (completed as Oil, Gas or Dry Hole) Oil
Date well completed September 1 19 34
Application for plugging filed September 21 19 43
Application for plugging approved September 21, 19 43
Plugging commenced September 22, 19 43
Plugging completed September 27 19 43
Reason for abandonment of well or producing formation To stop loss of money and salvage well equipment.
If a producing well is abandoned, date of last production June 28, 19 43
Was permission obtained from the Conservation Division or its agents before plugging was commenced? Yes

Name of Conservation Agent who supervised plugging of this well Mr. Ruel Durkee, McPherson, Kansas
Producing formation Hunton Lime Depth to top 3403 Bottom 3413 Total Depth of Well 3413 Feet
Show depth and thickness of all water, oil and gas formations.

OIL, GAS OR WATER RECORDS

CASING RECORD

Formation	Content	From	To	Size	Put In	Pulled Out
Kansas City Lime	12 BWPD - No Oil	2499	2509	13-3/8"	280	None
"	192 " "	2548	2558	9"	3154	2140
"	240 " "	2817	2824	7"	3405	2920
"	No Oil or water	2925	2960	2 1/2"	3000	3000
Mississippi Lime	" "	3147	3403			
Hunton Lime	252 BOPD	3409	3413			

Describe in detail the manner in which the well was plugged, indicating where the mud fluid was placed and the method or methods used in introducing it into the hold. If cement or other plugs were used, state the character of same and depth placed, from _____ feet to _____ feet for each plug set.

Gravel from top of Lane-Wells Drillable Plug at 2525 to 2490

Bridged 8 Sax cement 2490 to 2466

Filled heavy mud 2466 to 275

Bridged 20 Sax cement 275 to 249

Filled heavy mud from 249 to 10' below cellar

8 Sax cement 10' to top casing in cellar

Screwed steel cap on 13-3/8" casing in bottom of cellar

PLUGGING
FILE 30 22-34
HOOK PAGE 91-LINE 39

(If additional description is necessary, use BACK of this sheet)

Correspondence regarding this well should be addressed to Magnolia Petroleum Company
Address Box 888, Ellinwood, Kansas.

10-1-43

STATE OF Kansas, COUNTY OF Barton, ss.

John F. Conley (employee of owner) or (owner or operator) of the above-described well, being first duly sworn on oath, says: That I have knowledge of the facts, statements, and matters herein contained and the log of the above-described well as filed and that the same are true and correct. So help me God.

(Signature) *John F. Conley*

(Address)

SUBSCRIBED AND SWORN to before me this 28th day of September, 19 43

My commission expires 10/13/45

Le J. Peden
Notary Public.

