

STATE OF KANSAS
STATE CORPORATION COMMISSION

WELL PLUGGING RECORD


Give All Information Completely
Make Required Affidavit
Mail or Deliver Report to:
Conservation Division
State Corporation Commission
800 Bitting Building
Wichita, Kansas

OR

~~FORMATION PLUGGING RECORD~~

Strike out upper line
when reporting plug-
ging off formations.

NORTH

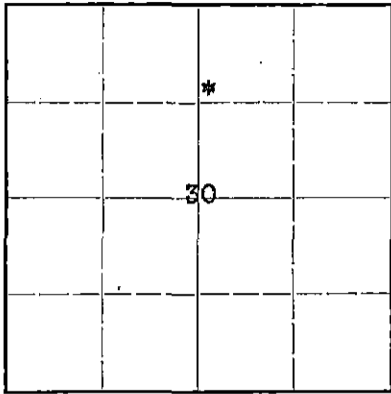

Locate well correctly on above
Section Plat

Harvey County Sec. 30 Twp. 22S Rge. (E) 3 (W)
Location as "NE 1/4 NW 1/4 SW 1/4" or footage from lines SW NW NE
Lease Owner Magnolia Petroleum Co.
Lease Name Katie Schmidt Well No. 4
Office Address RFD 1, Ellinwood, Kansas
Character of Well (completed as Oil, Gas or Dry Hole) Oil
Date well completed 12-31-33
Application for plugging filed by phone May 4, 1945
Application for plugging approved May 5, 1945
Plugging commenced May 5, 1945
Plugging completed May 10, 1945
Reason for abandonment of well or producing formation Production exhausted

If a producing well is abandoned, date of last production March 31, 1945
Was permission obtained from the Conservation Division or its agents before plugging was com-
menced? yes

Name of Conservation Agent who supervised plugging of this well Mr. Ruel Durkee
Producing formation See log Depth to top Bottom Total Depth of Well 3594 Feet
Show depth and thickness of all water, oil and gas formations.

OIL, GAS OR WATER RECORDS


CASING RECORD

Formation	Content	From	To	Size	Put In	Pulled Out
Lansing-Kansas City	Water	2450	3120	15 1/2"	452	none
Hunton Lime	Oil	3347	3476	8-5/8"	3347	2496
Viola Lime	water	3476	3498	5 1/2"	3590	2939
Simpson Formation	oil	3498	3582			
Arbuckle lime	oil	3582	3594			

Describe in detail the manner in which the well was plugged, indicating where the mud fluid was placed and the method or methods used in introducing it into the hold. If cement or other plugs were used, state the character of same and depth placed, from feet to feet for each plug set.

Plugged back with wood plug and 9 sax cement from 3594 to 3573.
Dumped 21 sax cement with dump bailer filled up 3573 to 3497.
Shot 5 1/2" at 3320, 3200, 3050, 2939, came out at 2939.
Set bridge of 8 sax cement, tree limbs and crushed rock at 2559. Shot off 8-5/8" at 2496'
Mudded with hand shovels and slip from 2559 to 300, while pulling 8-5/8" casing
Bridged with field rock and 30 sax cement from 300 to 210'.
Mudded with hand shovels and slip from 210 to 15'.
Bridged with 10 sax cement from 15 to 6' or bottom of cellar.
Filled with surface soil to top

PLUGGING
FILE # 30 22S 30W
BOOK PAGE 12 ONE 25

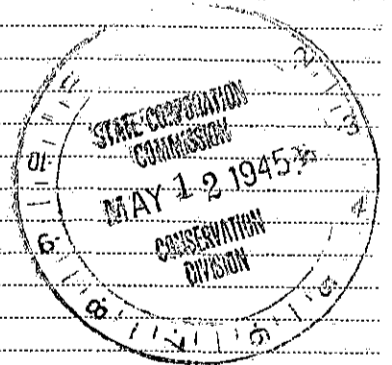

(If additional description is necessary, use BACK of this sheet)

Correspondence regarding this well should be addressed to Magnolia Petroleum Company
Address RFD 1, Ellinwood, Kansas

STATE OF Kansas, COUNTY OF Barton, ss.
Russel Clymer (employee of owner) or (conservation agent) of the above-described well,
being first duly sworn on oath, says: That I have knowledge of the facts, statements, and matters herein contained and the log of the above-described well as filed and that the same are true and correct. So help me God.

(Signature) Russel Clymer
RFD 1, Ellinwood, Kansas
(Address)

SUBSCRIBED AND SWORN to before me this 11 day of May, 1945
Notary Public.

My commission expires October 13, 1945