

STATE OF KANSAS
STATE CORPORATION COMMISSION

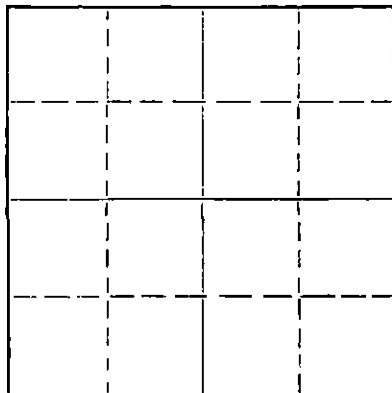
Form CP-4

Give All Information Completely
Make Required Affidavit
Mail or Deliver Report to:
Conservation Division
State Corporation Commission
211 No. Broadway
Wichita, Kansas

WELL PLUGGING RECORD

62

NORTH

Locate well correctly on above
Section Plat

Harvey County, Sec. 30 Twp. 22 Rge. 3 ~~SE~~ W (W)
Location as "NE/CNW&SW¼" or footage from lines. G SE SW
Lease Owner Drillers Production Company, Inc.
Lease Name Franz Well No. 1
Office Address Wichita, Kansas
Character of Well (completed as Oil, Gas or Dry Hole) _____
Date well completed _____ 19____
Application for plugging filed _____ 19____
Application for plugging approved _____ 19____
Plugging commenced 12-2-64 _____ 19____
Plugging completed 12-3-64 _____ 19____
Reason for abandonment of well or producing formation Depleted.

If a producing well is abandoned, date of last production _____ 19____
Was permission obtained from the Conservation Division or its agents before plugging was commenced? yes

Name of Conservation Agent who supervised plugging of this well Gilbert Toman
Producing formation _____ Depth to top _____ Bottom _____ Total Depth of Well 620 Feet
Show depth and thickness of all water, oil and gas formations.

OIL, GAS OR WATER RECORDS

CASING RECORD

FORMATION	CONTENT	FROM	TO	SIZE	PUT IN	PULLED OUT
				8-5/8"	343'	None
				5-1/2"	486'	

Describe in detail the manner in which the well was plugged, indicating where the mud fluid was placed and the method or methods used in introducing it into the hole. If cement or other plugs were used, state the character of same and depth placed, from _____ feet to _____ feet for each plug set.

Checked hole, sanded hole to 480' and dumped 5 sacks of cement @ 480' with dump bailer. Pulled 5 1/2" casing, bailed hole to 330', set rock bridge to 320' and dumped 20 sacks of cement @ 320'. Mudded hole to 30' and ran 10 sacks of cement to base of cellar.

RECEIVED
STATE CORPORATION COMMISSION

DEC 14 1964

CONSERVATION DIVISION
Wichita, Kansas

PLUGGING COMPLETE.

12-14-64

(If additional description is necessary, use BACK of this sheet)

Name of Plugging Contractor KNIGHT CASING PULLING COMPANY
Address CHASE, KANSAS

STATE OF KANSAS, COUNTY OF RICE, ss.
Noel J. Knight (employee of owner) or (~~NOTICE OF ABSENCE~~) of the above-described

well, being first duly sworn on oath, says: That I have knowledge of the facts, statements, and matters herein contained and the log of the above-described well as filed and that the same are true and correct. So help me God.

(Signature)

Noel J. Knight

Chase, Kansas

(Address)

SUBSCRIBED AND SWORN TO before me this 5th day of December, 1964

My commission expires May 20, 1968

Milton J. Volin

Notary Public.

R

GROUP EXPLORATION COMPANY
Sterling, Kansas

WELL LOG- -----Franz #1
located: C SE SW Section 30-22S-3W, Harvey County, Kansas.

OWNER: Drillers Production Company
ROTARY DRILLING CONTRACTOR: Group Exploration Company

COMMENCED: 12-30-63
COMPLETED: 1-5-64

ROTARY TOTAL DEPTH: 1979'

LOG

0 - 347	Sand & Shale	
347 - 625	Lime & Shale	
625 - 1195	Lime	
1195 - 1870	Lime & Shale	
1870 - 1979	Shale	T. D.

CASING RECORD

Set 8 5/8" Surface Casing at 343' K.B.
with 250 sacks HA-5.

Plug and abandoned due to lost
circulation.

RECEIVED
STATE CORPORATION COMMISSION

FEB 3 1964

CONSERVATION DIVISION
Wichita, Kansas

DRILLERS PRODUCTION CO., INC.

1020 UNION NATIONAL BUILDING

WICHITA, KANSAS 67202

9

W E L L L O G

30-22-3W

Franz Lease Well No. 1 Location C-SE-SW Sec 30, Twp ~~33~~ Rge 3W Harvey Co.

Spud: 12-30-1963

8-5/8"OD Casing Set @ 343' w/ 250 sacks cement - Circulated to surface

Drilled to 1979' - lost circulation 494' to 497' - unable to regain circulation.

1-7-1964: Plugged and abandon - Plugged back to 300' - spotted 25 sacks cement - mud to 40' - 10 sacks cement to surface

February 6, 1964. Move in cable tools - drilled out cement plugs in surface pipe - swung tools to 620' - ran 5-1/2" Casing to 486' (No cement). Complete for Salt water disposal.