


STATE OF KANSAS
STATE CORPORATION COMMISSION

Give All Information Completely
Make Required Affidavit
Mail or Deliver Report to:
Conservation Division
State Corporation Commission
211 No. Broadway
Wichita, Kansas

WELL PLUGGING RECORD

NORTH

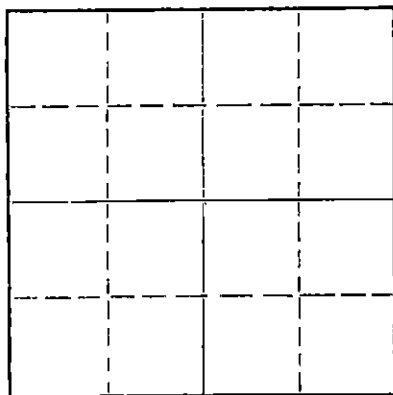

Locate well correctly on above
Section Plat

Harvey County, Sec. 30 Twp. 22S Rge. 3W (E) (W)
Location as "NE/CNW/SW" or footage from lines C SE SW
Lease Owner Drillers Production Company, Inc.
Lease Name Franz Well No. 1
Office Address 1020 Union National Building, Wichita 2, Kansas
Character of Well (completed as Oil, Gas or Dry Hole) Dry Hole
Date well completed January 5 1964
Application for plugging filed January 5 1964
Application for plugging approved January 5 1964
Plugging commenced January 5 1964
Plugging completed January 5 1964
Reason for abandonment of well or producing formation

If a producing well is abandoned, date of last production 19
Was permission obtained from the Conservation Division or its agents before plugging was commenced? yes

Name of Conservation Agent who supervised plugging of this well Cecil Jones, McPherson, Kansas
Producing formation Depth to top Bottom Total Depth of Well 1979' Feet
Show depth and thickness of all water, oil and gas formations.

OIL, GAS OR WATER RECORDS

CASING RECORD

FORMATION	CONTENT	FROM	TO	SIZE	PUT IN	PULLED OUT
				8 5/8"	334.88	none
					set at 343'	

Describe in detail the manner in which the well was plugged, indicating where the mud fluid was placed and the method or methods used in introducing it into the hole. If cement or other plugs were used, state the character of same and depth placed, from feet to feet for each plug set.

Heavy mud up to 400'. Howco plug at 400' with 1/4 sack hulls. 100' of gravel to 300'. Howco plug at 300' with 1/4 sack hulls. 45 sacks regular cement through drill pipe. Mud to 40'. Howco plug at 40' with 1/4 sack hulls. 8 sacks regular cement to surface.

2 sacks cement in rathole.

Plugging completed at 2:00 p. m.

2-3-64

RECEIVED
STATE CORPORATION COMMISSION

FEB 3 1964

CONSERVATION DIVISION
Wichita, Kansas

(If additional description is necessary, use BACK of this sheet)

Name of Plugging Contractor Group Exploration Company
Address Box 127, Sterling, Kansas

STATE OF KANSAS, COUNTY OF RICE, ss.
F. A. Wuellner

(employee of owner) or (owner or operator) of the above-described well, being first duly sworn on oath, says: That I have knowledge of the facts, statements, and matters herein contained and the log of the above-described well as filed and that the same are true and correct. So help me God. GROUP EXPLORATION COMPANY

(Signature) F. A. Wuellner, Partner
Sterling, Kansas

(Address)

SUBSCRIBED AND SWORN to before me this 31st day of January, 1964

My Commission Expires Jan. 22, 1966
BERNARD LAUDERMILK

My commission expires

Bernard Laudermilk
Bernard Laudermilk, Notary Public.

My Commission Expires Jan. 22, 1966
BERNARD LAUDERMILK

R

GROUP EXPLORATION COMPANY
Sterling, Kansas

WELL LOG- ----- Franz #1
Located: C SE SW Section 30-22S-3W, Harvey County, Kansas.

OWNER: Drillers Production Company
ROTARY DRILLING CONTRACTOR: Group Exploration Company

COMMENCED: 12-30-63
COMPLETED: 1- 5-64

ROTARY TOTAL DEPTH: 1979'

LOG

0 - 347	Sand & Shale	
347 - 625	Lime & Shale	
625 - 1195	Lime	
1195 - 1870	Lime & Shale	
1870 - 1979	Shale	T. D.

CASING RECORD

Set 8 5/8" Surface Casing at 343' K.B.
with 250 sacks HA-5.

Plug and abandoned due to lost
circulation.

RECEIVED
STATE CORPORATION COMMISSION

FEB 3 1964

CONSERVATION DIVISION
Wichita, Kansas