


STATE OF KANSAS
STATE CORPORATION COMMISSION

Give All Information Completely
Make Required Affidavit
Mail or Deliver Report to:
Conservation Division
State Corporation Commission
212 No. Market
Wichita, Kansas 67202

NORTH

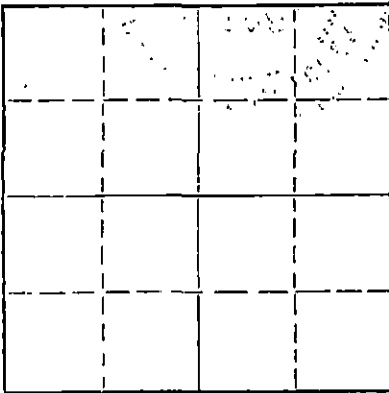

Locate well correctly on above
Section Plat

WELL PLUGGING RECORD

Harvey County. Sec. 30 Twp. 22 Rge. 3 (W)
Location as "NE/CNW4SW4" or footage from lines. 330 W C SE/4 SW/4
Lease Owner Drillers Production Company
Lease Name Franz IA Well No.
Office Address Wichita, Kansas 67202
Character of Well (completed as Oil, Gas or Dry Hole)
Date well completed 19
Application for plugging filed 19
Application for plugging approved 19
Plugging commenced 8/26/70 19
Plugging completed 8/29/70 19
Reason for abandonment of well or producing formation depleted.
If a producing well is abandoned, date of last production 19
Was permission obtained from the Conservation Division or its agents before plugging was commenced? yes
Name of Conservation Agent who supervised plugging of this well Scott
Producing formation Depth to top Bottom Total Depth of Well 3335 Feet
Show depth and thickness of all water, oil and gas formations.

OIL, GAS OR WATER RECORDS

CASING RECORD

FORMATION	CONTENT	FROM	TO	SIZE	PUT IN	PULLED OUT
				18-3/8	352	none
				5 1/2"	3334'	2200'

Describe in detail the manner in which the well was plugged, indicating where the mud fluid was placed and the method or methods used in introducing it into the hole. If cement or other plugs were used, state the character of same and depth placed, from feet to feet for each plug set.

Checked hole to 3335' and ran sand to 3300', dumped 5 sacks of cement.
Loaded hole, shot pipe at 2387', 2193', pipe came loose, pulled 68 joints.
Bailed fluid down to 370', rock bridge to 360' and dumped 35 sacks of cement. Mudded to 40', 10' rock bridge and dumped 15 sacks of cement.

PLUGGING COMPLETE.

RECEIVED
STATE CORPORATION COMMISSION
SEP 4 1970
CONSERVATION DIVISION
Wichita, Kansas

(If additional description is necessary, use BACK of this sheet)
Name of Plugging Contractor KNIGHT CASING PULLING CO., INC.
Address CHASE, KANSAS

STATE OF KANSAS, COUNTY OF RICE, ss.

NOEL J. KNIGHT (employee of owner) or (owner or operator) of the above-described well, being first duly sworn on oath, says: That I have knowledge of the facts, statements, and matters herein contained and the log of the above-described well as filed and that the same are true and correct. So help me God.

(Signature)

CHASE, KANSAS

(Address)

SUBSCRIBED AND SWORN to before me this 31st day of August, 1970

My commission expires

2/15/71

Notary Public.

Drillers Production Co

Grang Well #1-A

GROUP EXPLORATION COMPANY
Sterling, KansasWELL LOG - Trans A #1
Located: 330' W of E SE SW Section 30-22S-3W, Harvey County, KansasOWNER: Drillers Production Company
ROTARY DRILLING CONTRACTOR: Group Exploration CompanyCOMMENCED: 1-5-64
COMPLETED: 1-18-64

ROTARY TOTAL DEPTH: 3335'

LOG

0 - 65	Clay
65 - 250	Sand
250 - 354	Shale
354 - 625	Lime & Shale
625 - 1265	Lime
1265 - 1635	Shale
1635 - 2130	Lime & Shale
2130 - 2315	Lime
2315 - 2495	Shale & Lime
2495 - 3150	Lime
3150 - 3225	Lime, Shale & Chert
3225 - 3297	Lime
3297 - 3330	Chert
3330 - 3335	Lime T.D.

CASING RECORDSet 13 3/8" Surface Casing at 352' K.B.
with 450 sacks regular with 2% HA-5.Ran 5 1/2" Used Pipe at 3334' K.B.
cemented with 250 sacks Regular Cement.RECEIVED
STATE CORPORATION COMMISSION
SEP 10 1970
CONSERVATION DIVISION
Wichita, Kansas