

STATE OF KANSAS  
STATE CORPORATION COMMISSION


Give All Information Completely  
Make Required Affidavit  
Mail or Deliver Report to:  
Conservation Division  
State Corporation Commission  
211 No. Broadway  
Wichita, Kansas

WELL PLUGGING RECORD

Stafford County. Sec. 9 Twp. 22 Rge. 11E (E) (W)

Location as "NE/CNW/SW" or footage from line NE SE NE  
Lease Owner Nadel & Gussman  
Lease Name Fair Well No. 2  
Office Address Box 14 Great Bend, Kansas  
Character of Well (completed as Oil, Gas or Dry Hole) Oil  
Date well completed \_\_\_\_\_ 19\_\_\_\_  
Application for plugging filed \_\_\_\_\_ 19\_\_\_\_  
Application for plugging approved \_\_\_\_\_ 19\_\_\_\_  
Plugging commenced October 18, 1962 19\_\_\_\_  
Plugging completed October 20, 1962 19\_\_\_\_  
Reason for abandonment of well or producing formation Dry

NORTH

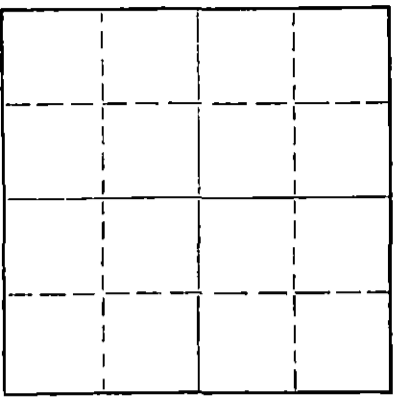

Locate well correctly on above Section Flat

If a producing well is abandoned, date of last production \_\_\_\_\_ 19\_\_\_\_  
Was permission obtained from the Conservation Division or its agents before plugging was commenced? Yes

Name of Conservation Agent who supervised plugging of this well W. L. Lackamp  
Producing formation \_\_\_\_\_ Depth to top \_\_\_\_\_ Bottom \_\_\_\_\_ Total Depth of Well PB 3357 Feet  
Show depth and thickness of all water, oil and gas formations.

OIL, GAS OR WATER RECORDS

CASING RECORD

FORMATION	CONTENT	FROM	TO	SIZE	PUT IN	PULLED OUT
				8 5/8	266	none
				4 1/2	3402	2924

Describe in detail the manner in which the well was plugged, indicating where the mud fluid was placed and the method or methods used in introducing it into the hole. If cement or other plugs were used, state the character of same and depth placed, from \_\_\_\_\_ feet to \_\_\_\_\_ feet for each plug set.

Moved in and cleaned out cellar, sanded to 3220' and dumped 4 sacks cement.  
Loaded hole with water and worked pipe. Shot @ 3000'-2907' and started pulling pipe.  
Pulled pipe and plugged and bailed water. Built rock bridge @ 240' and dumped 20 sacks cement. Filled hole and rock bridge and capped well with 10 sacks cement.

RECEIVED  
STATE CORPORATION COMMISSION  
NOV 13 1962  
CONSERVATION DIVISION  
Wichita, Kansas

11-13-62

(If additional description is necessary, use BACK of this sheet)

Name of Plugging Contractor Forbes Casing Pulling, Inc.  
Address Box 221 Great Bend, Kansas

STATE OF Kansas, COUNTY OF Barton, ss.  
J. O. Forbes (employee of owner) or (owner or operator) of the above-described well, being first duly sworn on oath, says: That I have knowledge of the facts, statements, and matters herein contained and the log of the above-described well as filed and that the same are true and correct. So help me God.

(Signature) J. O. Forbes  
Box 221 Great Bend, Ks. (Address)

SUBSCRIBED AND SWORN TO before me this 22<sup>nd</sup> day of October, 1963

My commission expires July 23, 1966

Carolyn Heron Notary Public.

WELL LOG

Date started 11-7-60  
Date completed 11-17-60

Pair #2 NW SE NE  
Section 19, Township 22 Range 11W  
Stafford County, Kansas

	1764 KB
Anhydrite	558' - 1206'
Heebner	3002' - 1238'
Brown line	3140' - 1376'
Lansing - R.C.	3166' - 1402'
Conglomerate	3442' - 1678'
Simpson	3509' - 1745'
Arbuckle	3539' - 1775'
Total Depth	3560'

- 0' - 266' Shale and shells
- 266' - 730' Shale
- 730' - 1375' Shale and shells
- 1375' - 2375' Shale and lime
- 2375' - 2635' Shale and shells
- 2635' - 3230' Lime and shale
- 3230' - 3300' Lime
- 3300' - 3370' Lime and shale
- 3370' - 3470' Lime
- 3470' - 3530' Lime and shale
- 3530' - 3560' Lime

RECEIVED  
STATE CORPORATION COMMISSION  
NOV 13 1962  
CONSERVATION DIVISION  
Wichita, Kansas


Affidavit

State of Kansas . . . . . County of Barton

I, A. M. Jones certify that the above is a true and correct log as reflected by Daily drilling reports of the Jones Drilling Company.

By: A. M. Jones  
A. M. Jones, Owner

Subscribed and sworn before me this 29th day of November, 1960.

  
John W. Poos Notary Public

My commission expires April 11, 1963.