


WELL PLUGGING RECORD

Give All Information Completely  
Make Required Affidavit  
Mail or Deliver Report to:  
Conservation Division  
State Corporation Commission  
800 Bittling Building  
Wichita, Kansas

NORTH

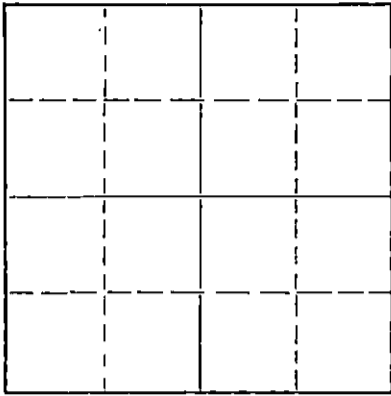

Locate well correctly on above  
Section Plat

Stafford County. Sec. 9 Twp. 22 Rge. 11 (X) (W)  
Location as "NE/CNWxSWx" or footage from lines SW NW SE  
Lease Owner Lee Phillips Oil Company  
Lease Name Eriksen Well No. 1  
Office Address 1407 Union National Bank Bldg., Wichita, Kansas  
Character of Well (completed as Oil, Gas or Dry Hole) dry hole  
Date well completed 2-24-55 19  
Application for plugging filed 2-24-55 19  
Application for plugging approved 2-24-55 19  
Plugging commenced 2-25-55 19  
Plugging completed 2-25-55 19  
Reason for abandonment of well or producing formation dry hole

If a producing well is abandoned, date of last production 19  
Was permission obtained from the Conservation Division or its agents before plugging was commenced? yes, verbally

Name of Conservation Agent who supervised plugging of this well  
Producing formation Depth to top Bottom Total Depth of Well 3592 Feet  
Show depth and thickness of all water, oil and gas formations.

OIL, GAS OR WATER RECORDS

CASING RECORD

FORMATION	CONTENT	FROM	TO	SIZE	PUT IN	PULLED OUT
None		0	279'	8 5/8"	279'	None

Describe in detail the manner in which the well was plugged, indicating where the mud fluid was placed and the method or methods used in introducing it into the hole. If cement or other plugs were used, state the character of same and depth placed, from feet to feet for each plug set.

Filled hole with heavy mud, set plug at 270' with 20  
sax cement, filled with heavy mud, set another plug at 35'  
with 10 sax cement, and leveled location.

(If additional description is necessary, use BACK of this sheet)

Name of Plugging Contractor Ben F. Brack Oil Company, Inc. (drilling contractor)  
Address 309 Brown Building, Wichita, Kansas

STATE OF KANSAS, COUNTY OF SEDGWICK, ss.  
Nelle A. Salmon (employee of owner) or (owner or operator) of the above-described

well, being first duly sworn on oath, says: That I have knowledge of the facts, statements, and matters herein contained and the log of the above-described well as filed and that the same are true and correct. So help me God.

(Signature) Nelle A. Salmon

1407 Union Nat'l. Bank Bldg., Wichita, Kansas  
(Address)

SUBSCRIBED AND SWORN to before me this 28th day of February, 19 55

My commission expires March 5, 1956

Claire Jones Notary Public.

RECEIVED  
MAR 11 1955  
CONSERVATION DIVISION  
Wichita, Kansas  
PLUGGING  
FILED MAR 9 7 22 P.M.  
BACK PACK 100 LINE 4

BEN F. BRACK OIL COMPANY, INC.  
309-10 BROWN BUILDING  
WICHITA 2, KANSAS

ERIKSEN #1

SW NW SE

Sec. 9-22-11W  
Stafford County, Kansas  
Commenced: 2-15-55  
Completed: 2-25-55

TOTAL DEPTH: 3592'

=====

WELL LOG

Surface Soil & Sand	0 -	40'
Shale & Shells		278
Red Bed & Shale		465
Anhydrite		495
Red Bed, Blue & Gray Shale		960
Blue Shale		1350
Lime		1385
Sandy Lime & Shale		1560
Lime & Shale		1940
Shale & Shells		2180
Shale & Broken Lime Streets		2430
Shale & Lime Streaks		2790
Lime & Shale		2930
Lime		3004
Shale & Lime		3080
Lime & Shale		3150
Lime		3402
Shale & Lime		3440
Cherty Lime		3480
Shale & Lime		3561
Lime		3592' T.D. D. & A.

The above depths denote bottom of formations.

CASING

8 5/8" 279'

To the Best of my knowledge, the above is a true and correct statement of the depths and formations and where found.

BEN F. BRACK OIL COMPANY, INC.

By Bernard D. Grant

WITNESSED:

Arthur C. ...

February 26, 1955.

RECORDED  
STATE OF KANSAS

PLUGGING  
CONSERVATION DIVISION  
Wichita, Kansas  
FILED IN SEC 9 T22 R 11W  
BOOK PAGE 100 LINE 4