


WELL PLUGGING RECORD

Give All Information Completely
Make Required Affidavit
Mail or Deliver Report to:
Conservation Division
State Corporation Commission
211 No. Broadway
Wichita, Kansas

Stafford County, Sec. 9 Twp. 22S Rge. 11W (X) (X)

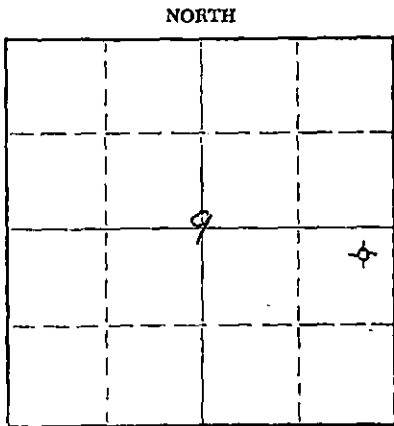

Locate well correctly on above Section Plat

Location as "NE/CNW/SW" or footage from lines NE NE SE
Lease Owner Mayfield-Smith Drlg. & Lario
Lease Name Eriksen Well No. 1
Office Address 928 Union Center Bldg., Wichita, Kans.
Character of Well (completed as Oil, Gas or Dry Hole) Dry Hole
Date well completed August 11 1962
Application for plugging filed August 11 1962
Application for plugging approved August 11 1962
Plugging commenced August 11 1962
Plugging completed August 11 1962
Reason for abandonment of well or producing formation Oil in commercial quantities not found.
If a producing well is abandoned, date of last production - - - 19-
Was permission obtained from the Conservation Division or its agents before plugging was commenced? Yes

Name of Conservation Agent who supervised plugging of this well W. L. Lackamp, R.R. #1, Stafford, Kansas
Producing formation - - Depth to top - - Bottom - - Total Depth of Well 3547 Feet
Show depth and thickness of all water, oil and gas formations.

OIL, GAS OR WATER RECORDS

CASING RECORD

FORMATION	CONTENT	FROM	TO	SIZE	PUT IN	PULLED OUT
				8 5/8"	266'	None

Describe in detail the manner in which the well was plugged, indicating where the mud fluid was placed and the method or methods used in introducing it into the hole. If cement or other plugs were used, state the character of same and depth placed, from _____ feet to _____ feet for each plug set.

Filled hole to 200' with heavy rotary mud.
Set #1 plug with 3 Gals. Hulls, 20 Skx. Cement, through drill pipe.
Filled hole to 35' with heavy rotary mud. Set #2 plug with
3 gals. hulls, 10 Skx. Cement to base of cellar.

*Rec'd
8-11-62*

(If additional description is necessary, use BACK of this sheet)
Name of Plugging Contractor Mayfield-Smith Drilling, Inc.
Address 928 Union Center Bldg., Wichita, Kansas

STATE OF KANSAS COUNTY OF SEDGWICK, ss.
Edgar E. Smith (employee of owner) or (owner or operator) of the above-described well, being first duly sworn on oath, says: That I have knowledge of the facts, statements, and matters herein contained and the log of the above-described well as filed and that the same are true and correct. So help me God.

(Signature) Edgar E. Smith
928 Union Center Bldg., Wichita, Kans.
(Address)

SUBSCRIBED AND SWORN TO before me this 13th day of August 19 62
Marguerite Mayfield
My commission expires 10-26-65 Marguerite Mayfield Notary Public.

