

STATE OF KANSAS
STATE CORPORATION COMMISSION


WELL PLUGGING RECORD

Give All Information Completely
Make Required Affidavit
Mail or Deliver Report to:
Conservation Division
State Corporation Commission
211 No. Broadway
Wichita, Kansas

Stafford County, Sec. 9 Twp. 22S Rge. (E) 11 (W)

Location as "NE/CNW/SW" or footage from lines C SE SE SE
Lease Owner Abercrombie Drilling, Inc.
Lease Name ERIKSEN Well No. 1
Office Address 801 Union Center, Wichita, Kansas 67202
Character of Well (completed as Oil, Gas or Dry Hole) Dry
Date well completed January 24, 19 65
Application for plugging filed January 23, 19 65
Application for plugging approved January 23, 19 65
Plugging commenced January 24, 19 65
Plugging completed January 24, 19 65
Reason for abandonment of well or producing formation Dry

NORTH

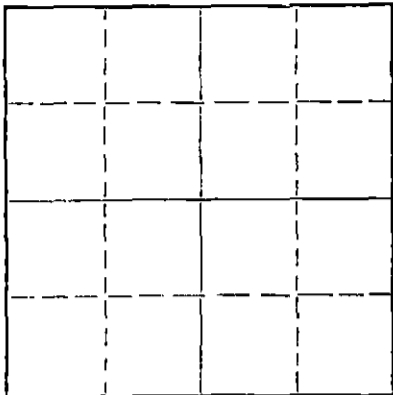

Locate well correctly on above
Section Plat

If a producing well is abandoned, date of last production 19
Was permission obtained from the Conservation Division or its agents before plugging was commenced? Verbally - yes

Name of Conservation Agent who supervised plugging of this well Archie Elbing
Producing formation _____ Depth to top _____ Bottom _____ Total Depth of Well 3575 Feet
Show depth and thickness of all water, oil and gas formations.

OIL, GAS OR WATER RECORDS

CASING RECORD

FORMATION	CONTENT	FROM	TO	SIZE	PUT IN	PULLED OUT
				7-5/8"	249	None

Describe in detail the manner in which the well was plugged, indicating where the mud fluid was placed and the method or methods used in introducing it into the hole. If cement or other plugs were used, state the character of same and depth placed, from _____ feet to _____ feet for each plug set.

Filled hole with heavy mud to 240'.
Set 1st plug at 240' w/1/4 sk hulls & 20 sx cement
Filled hole with heavy mud to 40'
Set 2nd plug at 40' w/10 sx cement.
Job completed 2 A. M. 1-24-65

STATE CORPORATION COMMISSION

FEB 12 1965

CONSERVATION DIVISION
WICHITA, KANSAS

2-12-65

(If additional description is necessary, use BACK of this sheet)

Name of Plugging Contractor Abercrombie Drilling, Inc.
Address 801 Union Center, Wichita, Kansas

STATE OF Kansas, COUNTY OF Sedgwick, ss.
Mildred Saxton (employee of owner) or (owner/operator) of the above-described well, being first duly sworn on oath, says: That I have knowledge of the facts, statements, and matters herein contained and the log of the above-described well as filed and that the same are true and correct. So help me God.

(Signature) Mildred Saxton
801 Union Center, Wichita, Kansas, 67202
(Address)

SUBSCRIBED AND SWORN to before me this 11th day of February, 19 65

Loch Jaye Hepler

Notary Public.

My commission expires June 16, 1967

CONTRACTOR'S WELL LOG

COMPANY: Abercrombie Drilling, Inc.
 CONTRACTOR: Abercrombie Drilling, Inc.
 FARM: #1 ERIKSEN
 LOCATION: C SE SE SE Sec. 9-22S-11W
 Stafford County, Kansas
 COMMENCED: January 14, 1965
 COMPLETED: January 24, 1965

0	75	Sand
75	175	Shale
175	260	Red Bed
260	720	Shale & Shells
720	1200	Shale
1200	2849	Shale & Lime
2849	3043	Lime
3043	3150	Shale & Lime
3150	3575	Lime
	3575	Rotary Total Depth

Set 7-5/8" surface casing at 249 feet with 175 sx cement.

DRY & ABANDONED

ELEVATION: 1779' G. L.
 1785' K. B. & D. F.

ELECTRIC LOG TOPS:

Heebner	3029'	(-1244)
Toronto	3048'	(-1263)
Douglas	3063'	(-1278)
Brown Lime	3168'	(-1383)
Lansing	3198'	(-1413)
Base Kansas City	3425'	(-1641)
Conglomerate	3452'	(-1667)
Simpson	3508'	(-1723)
Arbuckle	3555'	(-1770)

RECEIVED
 STATE CORPORATION COMMISSION

FEB 12 1965

CONSERVATION DIVISION
 Wichita, Kansas

STATE OF KANSAS)
) SS
 COUNTY OF SEDGWICK)

I, Mildred Saxton, do hereby certify that the above and foregoing is a true and correct copy of the log of the #1 ERIKSEN, C SE SE SE, Section 9-22S-11W, Stafford County, Kansas, as reflected by the files of Abercrombie Drilling, Inc.

Mildred Saxton
 Mildred Saxton

Subscribed and sworn to before me, a Notary Public, in and for Sedgwick County, Kansas, this 11th day of February, 1965.

Leah Faye Hefke
 Leah Faye Hefke, Notary Public

My commission expires June 16, 1967.