


WELL PLUGGING RECORD

Give All Information Completely
Make Required Affidavit
Mail or Deliver Report to:
Conservation Division
State Corporation Commission
211 No. Broadway
Wichita, Kansas

Stafford County, Sec. 9 Twp. 22 Rge. 11W (E) (W)

Location as "NE/CNW/SW" or footage from lines SE SE NE
Lease Owner Nadel & Gussman
Lease Name Fair Well No. 1
Office Address 625 Union Center Wichita, Kansas
Character of Well (completed as Oil, Gas or Dry Hole) Oil
Date well completed _____ 19____
Application for plugging filed October 12 1962
Application for plugging approved October 15 1962
Plugging commenced October 15, 1962 19____
Plugging completed October 18, 1962 19____
Reason for abandonment of well or producing formation Dry

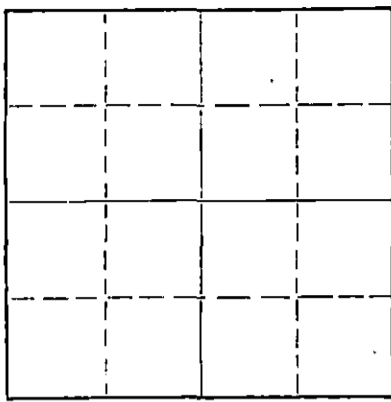

Locate well correctly on above
Section Plat

If a producing well is abandoned, date of last production _____ 19____
Was permission obtained from the Conservation Division or its agents before plugging was commenced? Yes

Name of Conservation Agent who supervised plugging of this well W. L. Lackamp
Producing formation _____ Depth to top _____ Bottom _____ Total Depth of Well 3320 Feet
Show depth and thickness of all water, oil and gas formations.


OIL, GAS OR WATER RECORDS

CASING RECORD

FORMATION	CONTENT	FROM	TO	SIZE	PUT IN	PULLED OUT
				8 5/8	260	none
				5 1/2	3563	2514

Describe in detail the manner in which the well was plugged, indicating where the mud fluid was placed and the method or methods used in introducing it into the hole. If cement or other plugs were used, state the character of same and depth placed, from _____ feet to _____ feet for each plug set.

Moved in and cleaned out cellar. Worked pipe and killed gas.
Sanded to 3220' and dumped 5 sacks cement. Worked pipe and loaded hole with water. Shot @2600'-2520'. Pulled 9 jts. and gas blew in. Killed gas.
Worked and started pipe. Pulled pipe.
Plugged well and bailed hole. Built rock bridge @240' and dumped 20 sacks cement. Filled hole and rock bridge and capped well with 10 sacks cement.

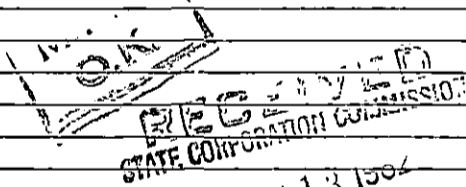

NOV 13 1962

11-13-62

CONSERVATION DIVISION
Wichita, Kansas

(If additional description is necessary, use BACK of this sheet)

Name of Plugging Contractor Forbes Casing Pulling, Inc.
Address Box 221 Great Bend, Kansas

STATE OF Kansas COUNTY OF Barton, ss.
J. O. Forbes (employee of owner) or (owner or operator) of the above-described well, being first duly sworn on oath, says: That I have knowledge of the facts, statements, and matters herein contained and the log of the above-described well as filed and that the same are true and correct. So help me God.

(Signature) J. O. Forbes
Box 221 St. Bend, Ks. (Address)

SUBSCRIBED AND SWORN to before me this 19th day of October, 1962

My commission expires July 23, 1966

Carolyn Herren Notary Public.

