


STATE OF KANSAS
STATE CORPORATION COMMISSION

WELL PLUGGING RECORD

Give All Information Completely
Make Required Affidavit
Mail or Deliver Report to:
Conservation Division
State Corporation Commission
211 No. Broadway
Wichita, Kansas

Stafford County, Sec. 9 Twp. 22 Rge. 11 (E) W (W)
Location as "NE/CNW/SW" or footage from lines NW/4 SW/4 NE/4
Lease Owner Republic Natural Gas Company
Lease Name Fair "A" Well No. 1
Office Address Box 126, Ellinwood, Kansas
Character of Well (completed as Oil, Gas or Dry Hole) Oil
Date well completed April 29 19 54
Application for plugging filed February 11 19 57
Application for plugging approved February 12 19 57
Plugging commenced February 19 19 57
Plugging completed February 25 19 57
Reason for abandonment of well or producing formation Depleted

NORTH

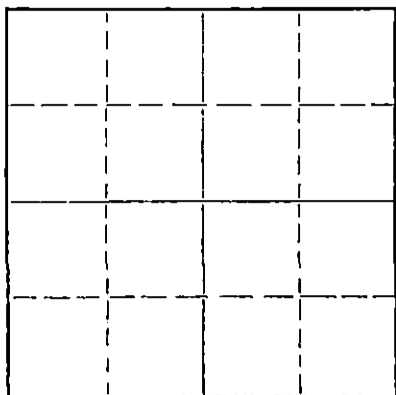

Locate well correctly on above
Section Plat

If a producing well is abandoned, date of last production November 20 19 56
Was permission obtained from the Conservation Division or its agents before plugging was commenced? Yes

Name of Conservation Agent who supervised plugging of this well R. M. Brundege
Producing formation Conglomerate Depth to top 3439 Bottom _____ Total Depth of Well 3560 Feet
Show depth and thickness of all water, oil and gas formations. PBTD 3490'

OIL, GAS OR WATER RECORDS

CASING RECORD

FORMATION	CONTENT	FROM	TO	SIZE	PUT IN	PULLED OUT
				8-5/8"	314'	None
				5-1/2"	3559'	2101'
<u>Conglomerate perforations:</u>						
<u>3466-3470</u>						
<u>3446-3454</u>						

Describe in detail the manner in which the well was plugged, indicating where the mud fluid was placed and the method or methods used in introducing it into the hole. If cement or other plugs were used, state the character of same and depth placed, from _____ feet to _____ feet for each plug set.

Sanded hole to 3435'. Dumped 5 sacks cement. Shot off casing at 2101'. Pulled casing. Pumped in 20 sacks mud and 75 sacks cement. Found top of cement 40' down from surface. Mudded to 15'. Dumped 5 sacks of cement to base of cellar.

(If additional description is necessary, use BACK of this sheet)

Name of Plugging Contractor R & D Casing Pulling Company
Address Ellinwood, Kansas

STATE OF Kansas, COUNTY OF Barton, ss.
P. B. Horst (employee of owner) or (~~owner or operator~~) of the above-described well, being first duly sworn on oath, says: That I have knowledge of the facts, statements, and matters herein contained and the log of the above-described well as filed and that the same are true and correct. So help me God.

(Signature) P. B. Horst
Box 126, Ellinwood, Kansas
(Address)

SUBSCRIBED AND SWORN TO before me this 6th day of March, 19 57

My commission expires 8-20-59

Yvonne M. Stearns
RECEIVED
STATE CORPORATION COMMISSION
Notary Public.

PLUGGING
FILE SEC 9 T. 22 R. 11W
BOOK PAGE 140 L' E. 11

RECEIVED
MAR 17 - 1957
3-7-57
CONSERVATION DIVISION
Wichita, Kansas

C-
O
P
Y

GABBERT-JONES DRILLING COMPANY
WICHITA, KANSAS
DRILLERS WELL LOG

J. H. Fair A-#1
NW SW NE Sec. 9-22-11W
Stafford County, Kansas
Commenced 3-19-54
Completed 4-1-54

<u>DEPTH</u>		<u>FORMATION</u>	<u>REMARKS</u>
From	To		
0	35	Surface Clay & Sand	
35	90	Shale	
90	260	Red Bed & Shells	
260	314	Red Bed	Ran 314.6' of 8 5/8" casing cemented at 314' w/160 sacks cement, 2% c.c.
314	460	Red Bed	
460	480	Anhydrite	
480	1045	Shale & Shells	
1045	1250	Shale & Salt	
1250	1490	Shale & Shells	
1490	1650	Lime & Shale	
1650	1800	Lime	
1800	2135	Lime & Shale	
2135	2265	Lime	
2265	3180	Lime & Shale	
3180	3452	Lime	
3452	3482	Conglomerate & Chert	
3482	3560	Lime	
3560	TD		Ran 3575.43' of 5 1/2" casing cemented at 3559' w/ 100 sacks cement.

Executed this 6th day of April, 1954

/s/ E. E. Hall

STATE OF KANSAS)
) ss
COUNTY OF SEDGWICK)

Before me, the undersigned, a Notary Public, within and for said County and State, on this 6th day of April, 1954 personally appeared E. E. Hall to me personally known to be the identical person who executed the within and foregoing instrument and acknowledged to me that he executed the same as his free and voluntary act and deed for the uses and purposes therein set forth.

IN WITNESS WHEREOF, I have hereunto set my hand and official seal the day and year last above written.

/s/ Mae Resco
Notary Public

My Commission Expires Mar. 28, 1957

(Seal)

