


WELL PLUGGING RECORD

Give All Information Completely
Make Required Affidavit
Mail or Deliver Report to:
Conservation Division
State Corporation Commission
800 Bittling Building
Wichita, Kansas

NORTH

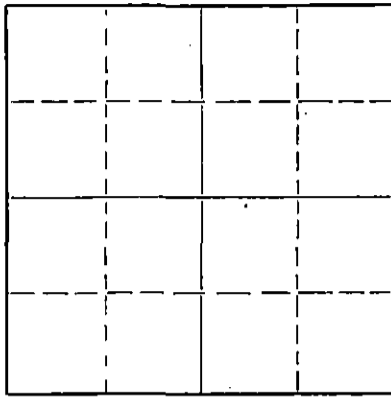

Locate well correctly on above
Section Plat

Location as "NE/CNW/SW" or footage from lines Finney County. Sec. 16 Twp. 22 Rge. (E) 33(W)
Lease Owner D.R. Lauck Oil Company, Inc.
Lease Name Euwer Well No. 1
Office Address Wichita, Kansas
Character of Well (completed as Oil, Gas or Dry Hole) dry hole
Date well completed Feb. 10 19 54
Application for plugging filed Feb. 10 19 54
Application for plugging approved Feb. 10 19 54
Plugging commenced Feb. 10 19 54
Plugging completed Feb. 10 19 54
Reason for abandonment of well or producing formation dry hole

If a producing well is abandoned, date of last production 19
Was permission obtained from the Conservation Division or its agents before plugging was commenced? yes

Name of Conservation Agent who supervised plugging of this well M. A. Rives
Producing formation none Depth to top Bottom Total Depth of Well 4800 Feet
Show depth and thickness of all water, oil and gas formations.

OIL, GAS OR WATER RECORDS

CASING RECORD

FORMATION	CONTENT	FROM	TO	SIZE	PUT IN	PULLED OUT
				8"	200'	none

Describe in detail the manner in which the well was plugged, indicating where the mud fluid was placed and the method or methods used in introducing it into the hole. If cement or other plugs were used, state the character of same and depth placed, from feet to feet for each plug set.

heavy mud 4800 - 200
wood plug 200 - 197
cement 197 - 157
heavy mud 157 - 29
wood plug 29 - 26
cement 26 - 6 to bottom of cellar

2-18-54

(If additional description is necessary, use BACK of this sheet)
Name of Plugging Contractor none
Address

STATE OF Kansas, COUNTY OF Sedgwick, ss.
P. R. Bishop (employee of owner) or (owner or operator) of the above-described well, being first duly sworn on oath, says: That I have knowledge of the facts, statements, and matters herein contained and the log of the above-described well as filed and that the same are true and correct. So help me God.

(Signature) P R Bishop
Wichita Kansas
(Address)

SUBSCRIBED AND SWORN TO before me this 17 day of February, 19 54

My commission expires Sept. 14, 1955
Elizabeth Gay
Notary Public

24-2675-6 2-52-20M
PLUGGING
FILE SEC. 16 T 22 R 33W
BOOK PAGE 13 LINE 15

D. R. Lauck Oil Company, Inc.

Euwer #1 C# N $\frac{1}{2}$ SE NE

Sec. 16- 22- 33W
Finney County Kansas

Elevation: 2875 DF
2873 GF
2877 KB

Commenced: January 19, 1954
Completed February 10, 1954

Casing Record: 8 5/8" 200'

shale	200
shale & sand	750
shale, shells & sand	970
red bed & shale	1335
Anhydrite	1355
Red bed & sh & sh	1730
salt & shale	1810
shale & shells	2140
lime & shale	3010
lime	3170
lime- hard	3200
lime	3245
lime & shale	3810
lime	4800

	<u>Tops</u>
Neebner	3762
Lansing	3805
Drum	4010
Base of K.C.	42.82
Marmaton	4302
Miss.	4658
T.D.	4800

TD 4800

D & A

PLUGGING
FILE SEC 16 T 22 R 33W
BOOK PAGE 13 LINE 15

Center Kansas