


STATE OF KANSAS
STATE CORPORATION COMMISSION

Form CP-4

Give All Information Completely
Make Required Affidavit
Mail or Deliver Report to:
Conservation Division
State Corporation Commission
212 No. Market
Wichita, Kansas 67202

WELL PLUGGING RECORD

Location as "NE/CNW/SW" or footage from lines Finney County, Sec. 16 Twp. 22S Rge. 33 (X) (W)
Location as "NE/CNW/SW" or footage from lines C-SE-SW
Lease Owner Texaco Inc.
Lease Name E. P. Ward Well No. 1
Office Address P. O. Box 2420, Tulsa, Okla.
Character of Well (completed as Oil, Gas or Dry Hole) Oil
Date well completed 4-10-65 19
Application for plugging filed 10-7-73 19
Application for plugging approved 10-9-73 19
Plugging commenced 11-3-73 19
Plugging completed 11-4-73 19
Reason for abandonment of well or producing formation depleted
If a producing well is abandoned, date of last production 9-21-72 19
Was permission obtained from the Conservation Division or its agents before plugging was commenced? Yes

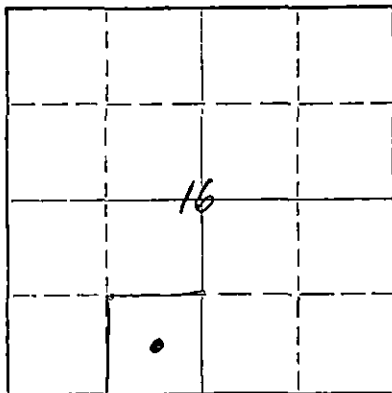

Locate well correctly on above Section Plat

Name of Conservation Agent who supervised plugging of this well Ed Eves
Producing formation Miss & Ft. Scott Depth to top 4632' Bottom _____ Total Depth of Well 4830 Feet
Show depth and thickness of all water, oil and gas formations.

OIL, GAS OR WATER RECORDS

CASING RECORD

FORMATION	CONTENT	FROM	TO	SIZE	PUT IN	PULLED OUT
Mississippi	Oil	4427	4633	4 1/2"	4830'	none
Ft. Scott	Oil	4436	4760'	8-5/8"	403'	none

Describe in detail the manner in which the well was plugged, indicating where the mud fluid was placed and the method or methods used in introducing it into the hole. If cement or other plugs were used, state the character of same and depth placed, from _____ feet to _____ feet for each plug set.

The well was plugged as follows: From 4763-2997' w/hvy drlg mud, 2997-2600' w/35 sx cmt, 2600-420 w/hvy drlg mud, 420-0' w/40 sx cmt.

RECEIVED
STATE CORPORATION COMMISSION
JAN 2 1974
CONSERVATION DIVISION
Wichita, Kansas

(If additional description is necessary, use BACK of this sheet)
Name of Plugging Contractor Sargents Casing Pulling Service
Address _____

STATE OF Oklahoma, COUNTY OF Tulsa, ss.
J. E. LUNDAY (employee of owner) or (owner or operator) of the above-described well, being first duly sworn on oath, says: That I have knowledge of the facts, statements, and matters herein contained and the log of the above-described well as filed and that the same are true and correct. So help me God

(Signature) [Signature]
P. O. Box 2420, Tulsa, Okla. 74102
(Address)

SUBSCRIBED AND SWORN TO before me this 27th day of December, 1973

My commission expires 11-25-74 W. M. Telle Notary Public.

WELL LOG

15-655-00034-0000

COMPANY THE TEXAS COMPANY

SEC. 16 T. 22S R. 33W

FARM #1 P. WARD

NO. 1

LOC. C-36, SW


TOTAL DEPTH 4830'

COUNTY PINNEY CO., KANSAS

COMM. March 13, 1959

COMP. April 1, 1959

CONTRACTOR GARVEY DRILLING COMPANY

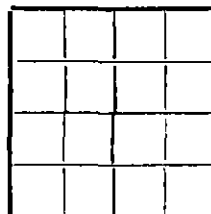

CASING 8 5/8" @ 403' W/400 sax.
4 1/2" @ 4830' W/975 sax.

ELEVATION

PRODUCTION

FIGURES INDICATE BOTTOM OF FORMATIONS

300	Surface soil, sand & clay
340	Shale
1275	Shale & shells
1600	Shale & lime
1850	Sand & shale
2140	Shale & shells
3010	Lime & shale
3080	Lime
3170	Lime & shale
3290	Lime
3623	Lime, shale & chalk
3700	Lime & chalk
3790	Lime
3917	Lime w/chalk streaks
4830	Lime
4830	T. D.

RECEIVED
STATE CORPORATION COMMISSION
OCT 9 1973
CONSERVATION DIVISION
Wichita, Kansas

State of KANSAS }
County of BARTON } ss:

I, VERNE A. MORRIS of GARVEY DRILLING COMPANY

upon oath state that the above and foregoing is a true and correct copy of the log of the #1 E. P. WARD well

Subscribed and sworn to before me this 8th day of April 19 59

My Commission Expires: November 12, 1962

Verne A. Morris
[Signature]
NOTARY PUBLIC