

Give All Information Completely
Make Required Affidavit
Mail or Deliver Report to:
Conservation Division
State Corporation Commission
800 Bittling Building
Wichita, Kansas

Copy
9-19-52
[Signature]

WELL PLUGGING RECORD

Stafford County, Sec. 12 Twp. 22 Rge. 14 (E) 14 (W)

Location as "NE/CNW $\frac{1}{4}$ /SW $\frac{1}{4}$ " or footage from lines NE NW SE

Lease Owner Westgate-Greenland Oil Company

Lease Name Roach-Wilson Well No. 1

Office Address 1009 Central Building, Wichita 2, Kansas

Character of Well (completed as Oil, Gas or Dry Hole) oil

Date well completed July 26, 1951 19

Application for plugging filed June 28, 1952 19

Application for plugging approved June 30, 1952 19


Plugging commenced July 22, 1952 19

Plugging completed August 4, 1952 19

Reason for abandonment of well or producing formation well not producing in commercial quantity

If a producing well is abandoned, date of last production July 8, 1952 19

Was permission obtained from the Conservation Division or its agents before plugging was commenced? yes

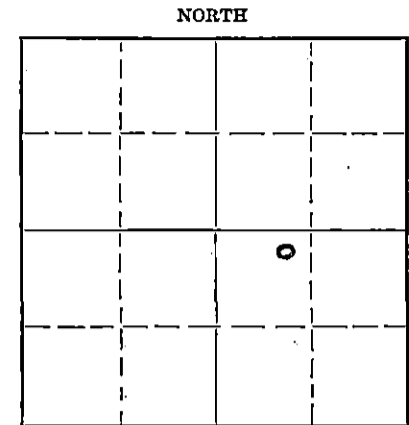

Locate well correctly on above Section Plat

Name of Conservation Agent who supervised plugging of this well M. A. Rives

Producing formation Arbuckle Depth to top 3751 Bottom Total Depth of Well 3791 Feet

Show depth and thickness of all water, oil and gas formations.

OIL, GAS OR WATER RECORDS

CASING RECORD

Formation	Content	From	To	Size	Put In	Pulled Out
Surface		0	324'	8 5/8"	324'	None
Arbuckle	oil	0	3793	5 1/2"	3793	3021'

Describe in detail the manner in which the well was plugged, indicating where the mud fluid was placed and the method or methods used in introducing it into the hole. If cement or other plugs were used, state the character of same and depth placed, from _____ feet to _____ feet for each plug set.

Filled hole with sand from 3793' to 3740'
Run 5 sacks cement from 3740 to 3700'
Filled with mud from 3700 to 300 feet
Ran 20 sacks cement from 300 to 260 feet
Filled with heavy mud from 260 to 35 feet
Capped with 10 sacks cement from 35 feet to cellar

STATE CORPORATION COMMISSION
SEP 20 1952
CONSERVATION DIVISION
Wichita, Kansas
9-20-52

Name of Plugging Contractor Morgan Well Plugging Service
Address 102 West 18th Street, Hutchinson, Kansas


STATE OF Kansas, COUNTY OF Sedgwick, ss.
G. E. Bitler (employee of owner) or (owner or operator) of the above-described well,

being first duly sworn on oath, says: That I have knowledge of the facts, statements, and matters herein contained and the log of the above-described well as filed and that the same are true and correct. So help me God.

(Signature) *G. E. Bitler*

SUBSCRIBED AND SWORN to before me this 20th day of September, 1952
Seward J. Freida
Notary Public.

My commission expires My Commission Expires Jan. 31, 1953

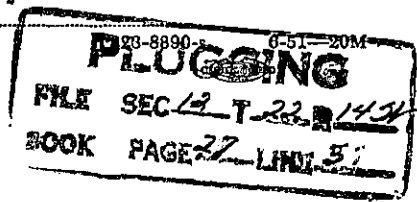

Please return to
Westgate-Greenland-Oil-Co
1009 Central, Building, Wichita, Kansas

COMPANY: Westgate-Greenland Oil Company
 CONTRACTOR: Jackson Drilling Corporation
 FARM: Roach-Wilson #1
 LOCATION: NE NW SE Sec 12-22-14W, Stafford County, Ks
 COMMENCED: July 6, 1951
 COMPLETED: July 20, 1951- Rotary
 July 26, 1951- Cardwell
 ELEVATION: 1932 DF

0	to	185	Sand
185	to	310	Shale and sand
310	to	324	Shells
324	to	462	Red bed and shale
462	to	522	Red bed and sand
522	to	800	Red bed
800	to	830	Anhydrite
830	to	1050	shale and salt
1050	to	1235	Shale and salt
1235	to	1350	Shale and sand
1350	to	1690	Shale and shells
1690	to	1982	Ft. Riley lime
1982	to	2055	Shale-lime
2055	to	2100	Shale-broken lime
2100	to	2750	Shale-lime
2750	to	3420	Lime and shale
3420	to	3453	K G Lime
3453	to	3674	Lime
3674	to	3698	Conglomerate
3698	to	3708	Viola
3700	to	3738	Shale
3738	to	3788	Lime
3708	to	3793	Arbuckle
		3793 (RB)	T. D.

RECEIVED
 STATE CORPORATION
 JUNE 20 1951
 CONSERVATION DIVISION
 WICHITA, KANSAS

Set 324 feet of 8 5/8" Surface pipe. Cemented with 225 sacks cement and 3 sacks calcium chloride.

Set 5 1/2" Casing @ 3793. Cemented with 75 sacks cement.

Perf. 72 holes 3751-3773. Swab. 30 DO in 7 hours natural. 7/26/51 Filed 25 HOPD affidavit.

Tops: Anhydrite 800 Heebner-3282 Ern Lime-3406 Lansing-3418
 Conglomerate-3658 Simpson-3697 Viola-3688 Arbuckle-3751
 (derrick floor measurements)

CERTIFICATE

I, G. E. Bitler, do hereby certify that the above and foregoing is a true and correct copy of log of the Roach-Wilson #1, Section 12-22-14W Stafford County, Kansas, as reflected by files of the Westgate-Greenland Oil Company.

G. E. Bitler
 G. E. Bitler

Subscribed and sworn to before me, a Notary Public, within and for Sedgewick County, Kansas, this 3rd day of August, 1951.

E. J. Russell
 Notary Public

My commission expires May 25, 1953.

PLUGGING
 ENT. #12-14-22-14W
 BOOK PAGE 27-1515