


Give All Information Completely  
Make Required Affidavit  
Mail or Deliver Report to:  
Conservation Division  
State Corporation Commission  
800 Bittling Building  
Wichita, Kansas

WELL PLUGGING RECORD

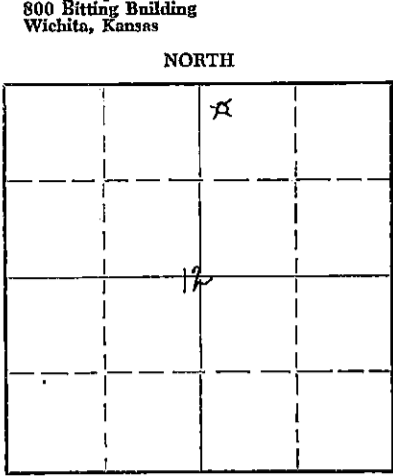

Locate well correctly on above Section Plat

Stafford County, Sec. 12 Twp. 22 Rge. (E) 14 (W)  
Location as "NE/CNW/SW" or footage from lines NW NW NE  
Lease Owner Thos. H. Allan, et al  
Lease Name Roach Well No. 2  
Office Address 1221 Union National Bank Building, Wichita 2, Kansas  
Character of Well (completed as Oil, Gas or Dry Hole) Dry Hole  
Date well completed December 17 19 53  
Application for plugging filed December 17 19 53  
Application for plugging approved December 17 19 53  
Plugging commenced December 18 19 53  
Plugging completed December 19 19 53  
Reason for abandonment of well or producing formation Dry Hole

If a producing well is abandoned, date of last production 19  
Was permission obtained from the Conservation Division or its agents before plugging was commenced? Yes

Name of Conservation Agent who supervised plugging of this well M. A. Rives  
Producing formation \_\_\_\_\_ Depth to top \_\_\_\_\_ Bottom \_\_\_\_\_ Total Depth of Well 3788 Feet  
Show depth and thickness of all water, oil and gas formations.

OIL, GAS OR WATER RECORDS

CASING RECORD

FORMATION	CONTENT	FROM	TO	SIZE	PUT IN	PULLED OUT
				8 5/8"	358'	None
				5 1/2"	3744'	3000.90'

Describe in detail the manner in which the well was plugged, indicating where the mud fluid was placed and the method or methods used in introducing it into the hole. If cement or other plugs were used, state the character of same and depth placed, from \_\_\_\_\_ feet to \_\_\_\_\_ feet for each plug set.

Lane Well Plug 3649

3649 - 3560 Gravel  
3560 - 3500 5 sacks of cement  
3500 - 300 Heavy Rotary mud  
300 - 250 Rock Bridge & 20 sacks cement  
250 - 35 Heavy Rotary mud  
35 - Surface Rock Bridge & 10 sacks cement

(If additional description is necessary, use BACK of this sheet)

Name of Plugging Contractor Thos. H. Allan  
Address 1221 Union National Bank Building, Wichita 2, Kansas


STATE OF KANSAS, COUNTY OF SEDGWICK, ss.  
Thos. H. Allan (employee of owner) or (owner or operator) of the above-described well, being first duly sworn on oath, says: That I have knowledge of the facts, statements, and matters herein contained and the log of the above-described well as filed and that the same are true and correct. So help me God.

(Signature) Thos. H. Allan  
1221 Union National Bank Building, Wichita, Ks.  
(Address)

SUBSCRIBED AND SWORN TO before me this 22nd day of December, 1953

Ocie M. Stewart  
Notary Public.

My commission expires June 14, 1954

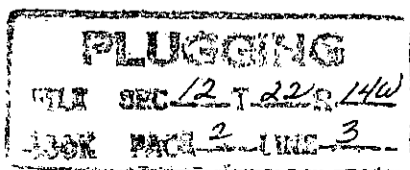

12-23-53

8 5/8" @ 1358' - 200 sx  
 5 1/2" @ 3744' - 100sx  
 Pulled 3000.90 ft.

ALLAN ET AL #2 ROACH  
 NW NW NE 12-22-14W  
 Stafford County, Kansas  
 COMM: 11/27/53 COMPL: 12/17/53  
 CONTRACTOR: Tom Allan  
 ELEVATION: 1928 RB

I.P. D & A

All Depths From Rotary Bushings

0 - 20 Soil  
 56 Clay  
 226 Sand  
 285 Blue Gumbo  
 315 Blue Gumbo and Sand  
 792 Red Beds  
 820 Anhydrite  
 1120 Red Beds  
 1320 Shale  
 1620 Salt & Shale  
 1800 Shale & Shells  
 1900 Lime & Shale  
 1925 Gray & Red Shale  
 2050 Lime  
 2080 Shale  
 2460 Lime & Shale  
 2980 Shale & Shells  
 3312 Lime & Shale Breaks  
 3401 Shale  
 3407 Brown Lime  
 3412 Shale  
 3439 Lime & Shale  
 3444 Soft Porous Lime  
 3480 Lime  
 3486 Soft Porous Lime  
 3495 Lime  
 3501 Oolitic Lime  
 3564 Lime with Shale Breaks  
 3574 Soft Porous Lime - Oil Stained  
 3664 Lime & Shale  
 3687 White & Buff Chert & Tripoli with dark oil stain  
 3734 Red & Green Shale  
 3744 (RTD) Weathered muddy Dolomite with spotted dark stain  
 3744 - 3746 SLM  
 3788 (TD) Weathered Porous Dolomite partly stained with dark oil Filled with gray-green mud

FORMATION TOPS:

Heebner	3275 RB
Brown Lime	3401 RB
Lansing	3412 RB
Viola	3664 RB
Simpson	3687 RB
Arbuckle	3734 RB

TESTING:

DST 3560-75 Open 1 hour recovered 38' of watery mud. BHP shut in 20 minutes 550#

Drilled shoe & drilled deeper to 3764 1/2 - No fluid

3764 1/2 - 67 Bailed 4 GOPH off bottom - would not fill up.

D.D. to 3786 No increase

3786-88 Filled up 1393' sulfur water - filled up 541' in last 8 hours. Set Lane Wells plug @ 3649'

Perf 24 shots 3563-68 - 500 gal. Acid.

Swab Test - Twelfth hour swab 6 gal. heavy black oil & 57 gal. salt water.

D & A

I certify that the above is a true and correct copy of the well log on the above test.

*Thos H. Allan*

Subscribed and sworn to before me this 18th day of December, 1953.

*Oris M. Stewart* Notary Public  
 My Commission expires June 14, 1954

