


STATE OF KANSAS
STATE CORPORATION COMMISSION

Give All Information Completely
Make Required Affidavit
Mail or Deliver Report to:
Conservation Division
State Corporation Commission
211 No. Broadway
Wichita, Kansas

~~15-185-13203-00-01~~ 15-185-13202-0001
REC'D NOV 10 1958
WELL PLUGGING RECORD

NORTH

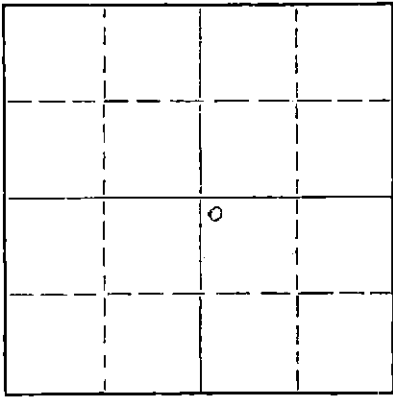

Locate well correctly on above
Section Plat

Stafford County, Sec. 11 Twp. 22 Rge. (E) 13 (W)
Location as "NE/CNW/SW" or footage from lines NW - NW - SE
Lease Owner E. K. Edmiston
Lease Name Drach Well No. 4
Office Address Wichita, Kansas
Character of Well (completed as Oil, Gas or Dry Hole) Oil Well
Date well completed January 10 19 55
Application for plugging filed November 12, 19 58
Application for plugging approved _____ 19 _____
Plugging commenced 10-30 19 58
Plugging completed 11-2 19 58
Reason for abandonment of well or producing formation used for S.W.D. Well
but would not take water
If a producing well is abandoned, date of last production _____ 19 _____
Was permission obtained from the Conservation Division or its agents before plugging was commenced? Yes

Name of Conservation Agent who supervised plugging of this well Frank Brodfoot
Producing formation Arbuckle Depth to top _____ Bottom _____ Total Depth of Well 3845 Feet
Show depth and thickness of all water, oil and gas formations.

OIL, GAS OR WATER RECORDS

CASING RECORD

FORMATION	CONTENT	FROM	TO	SIZE	PUT IN	PULLED OUT
				8 5/8	250	None
				5 1/2	3836	3098.26

Describe in detail the manner in which the well was plugged, indicating where the mud fluid was placed and the method or methods used in introducing it into the hole. If cement or other plugs were used, state the character of same and depth placed, from _____ feet to _____ feet for each plug set.

Sanded hole to 3580' - dumped 5 sks cement - mudded hole to 250' - set 10' rock bridge - dumped 20 sks cement - mudded hole to 35' - set 10' rock bridge - dumped 10 sks cement.

(If additional description is necessary, use BACK of this sheet)
Name of Plugging Contractor R & D Casing Pulling Company License # 236
Address Box 569 Ellinwood, Kansas

STATE OF Kansas, COUNTY OF Sedgwick, ss.
E. K. Edmiston (Employee of owner) or (owner or operator) of the above-described well, being first duly sworn on oath, says: That I have knowledge of the facts, statements, and matters herein contained and the log of the above-described well as filed and that the same are true and correct. So help me God.
(Signature) E. K. Edmiston
802 Union National Bldg. - Wichita, Kans. (Address)

SUBSCRIBED AND SWORN TO before me this 12th day of November 19 58

My commission expires 9-24-62

Maxine Johnson Notary Public.

PLUGGING
FILE SEC 11. T. 22. R. 13W
BOOK PAGE 140 LINE 36

REC'D NOV 14 1958
DIVISION
11-14-58

WELL LOG

15.185.13202-0000

COMPANY **Lindsley Drilling Company**

SEC. **11** T. **22** R. **13W**

FARM **Drach** NO. **4**

LOC. **NW $\frac{1}{4}$ NW $\frac{1}{4}$ SE $\frac{1}{4}$**

TOTAL DEPTH **3845'**

COUNTY **Stafford**
KANSAS


COMM. **12-29-54**

COMP. **1-10-55**

SHOT OR TREATED

CONTRACTOR **Louis Drilling Company**

ISSUED

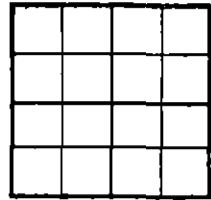

CASINO

20	10		
15	EX 8-5/8"	298'	
12	6		
13	EX 5-1/2"	3845'	

ELEVATION **1889 RB**

PRODUCTION

FIGURES INDICATE BOTTOM OF FORMATIONS

0	=	250	Clay & Sand
250	=	298	Red Bed
298	=	520	Red Bed & Shale
520	=	1630	Shale & Sand
1630	=	2275	Shale & Lime
2275	=	2510	Shale & Lime Stks
2510	=	2990	Shale
2990	=	3475	Shale & Lime
3475	=	3565	Lime
3565	=	3744	Lime & Shale
3744	=	3755	Shale
3755	=	3780	Lime & Shale
3780	=	3845	Arbuckle
3845	=	T.D.	

GEOLOGIC TOPS

Rebner	3224'
Brown Lime	3356'
Lansing	3384'
Conglomerate	3526'
Viola	3556'
Shannon	3706'
Arbuckle	3774'

RECEIVED
STATE CORPORATION COMMISSION

FEB 14 1955

CON. SIGN
Wichita, Kansas

PLUGGING
FILE SEC. 11 T. 22 R. 13W
BOOK PAGE 140 LINE 36

State of KANSAS }
County of SEDDWICK } SS:

I, Lo Lo Bailey of the Louis Drilling Company

upon oath state that the above and foregoing is a true and correct copy of the log of the Drach #4 well.

L. L. Bailey

Subscribed and sworn to before me this 15th day of January 19 55

My Commission Expires: August 20, 1956

Arthur P. Derrington
NOTARY PUBLIC