


STATE OF KANSAS
STATE CORPORATION COMMISSION

Form CP-4

WELL PLUGGING RECORD

Give All Information Completely
Make Required Affidavit
Mail or Deliver Report to:
Conservation Division
State Corporation Commission
212 No. Market
Wichita, Kansas

NORTH

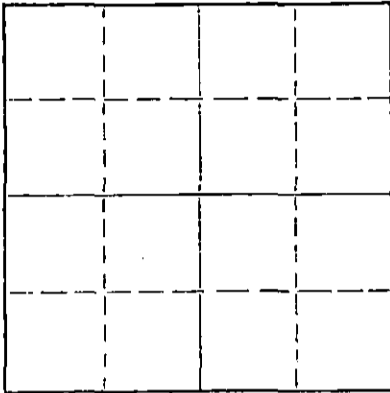

Locate well correctly on above
Section Plot

Stafford County. Sec. 10 Twp. 22S Rge. 13 1E1 (W)

Location as "NE/CNW4SW4" or footage from lines SW NE SE
Lease Owner Woody's Quality Oil Company
Lease Name Soeken "A" Well No. 3
Office Address 1119 Cravens Building, Oklahoma City, Oklahoma
Character of Well (completed as Oil, Gas or Dry Hole) Dry Hole (DWVO)
Date well completed April 25 1964
Application for plugging filed April 25 1964
Application for plugging approved April 25 1964
Plugging commenced April 25 1964
Plugging completed April 25 1964
Reason for abandonment of well or producing formation _____

If a producing well is abandoned, date of last production _____ 19____
Was permission obtained from the Conservation Division or its agents before plugging was commenced? Yes

Name of Conservation Agent who supervised plugging of this well Archie Elving
Producing formation _____ Depth to top _____ Bottom _____ Total Depth of Well 3880 Feet
Show depth and thickness of all water, oil and gas formations.

OIL, GAS OR WATER RECORDS

CASING RECORD

| FORMATION | CONTENT | FROM | TO | SIZE | PUT IN | PULLED OUT |
|-----------|---------|------|----|--------|--------|------------|
| | | | | 8 5/8" | 250' | None |
| | | | | | | |
| | | | | | | |
| | | | | | | |
| | | | | | | |
| | | | | | | |
| | | | | | | |
| | | | | | | |

Describe in detail the manner in which the well was plugged, indicating where the mud fluid was placed and the method or methods used in introducing it into the hole. If cement or other plugs were used, state the character of same and depth placed, from _____ feet to _____ feet for each plug set.

Hole filled with drilling mud from
3880 feet to 245 feet and cemented with
25 sacks, through the drill pipe. Hole
was filled with drilling mud to 40 feet;
2nd cementing plug, bridged with hulls
and cemented with 10 sacks to base of the
cellar. ; Rat and mouse hole bridged
and cemented with 5 sacks. Cementing done
by Halliburton Cementing Co.

RECEIVED
STATE CORPORATION COMMISSION
AUG 15 1966

(If additional description is necessary, use BACK of this sheet)
Name of Plugging Contractor Tommy Ward Drilling Company
Address 609 Liberty Bank Bldg., Oklahoma City, Oklahoma

CONSERVATION DIVISION
Wichita, Kansas

STATE OF OKLAHOMA, COUNTY OF LINCOLN, ss.

(employee of owner) or (owner or operator) of the above-described
well, being first duly sworn on oath, says: That I have knowledge of the facts, statements, and matters herein contained and the log of the
above-described well as filed and that the same are true and correct. So help me God.

(Signature) Tommy Ward

SUBSCRIBED AND SWORN TO before me this 11th day of August 1966
Charles E. Fisher
(Address)
Notary Public.

My commission expires Feb. 17, 1970

SOEKEN NO. 1

SW NE SE
Section 10-22S-13W
Stafford County, Kansas

Drilled for: Beardmore & Oil Trading Corp.
Drilled by: Beardmore Drilling Company

Casing Record:

8-5/8" 249' w/125 Sacks

Drilling Commenced: March 10, 1953
Drilling Completed: March 22, 1953

Elevation: DF 1890

| <u>FORMATION</u> | <u>DEPTH</u> |
|------------------|--------------|
| Sand | 210 |
| Shale - Shells | 1470 |
| Shale - Lime | 1665 |
| Lime | 1815 |
| Lime - Shale | 2060 |
| Shale - Lime | 2240 |
| Lime - Shale | 2665 |
| Shale - Lime | 2800 |
| Lime - Shale | 2935 |
| Lime Broken | 3020 |
| Lime | 3100 |
| Lime - Shale | 3160 |
| Lime | 3310 |
| Lime - Shale | 3390 |
| Lime | 3650 |
| Lime - Shale | 3715 |
| Lime | 3803 T.D. |

D & A

| TOPS: | |
|--------------|------|
| Heebner | 3251 |
| Brown Lime | 3379 |
| Lansing | 3400 |
| Conglomerate | 3663 |
| Viola | 3698 |
| Simpson | 3732 |
| Arbuckle | 3782 |

DST #1 - 3783-3791 - 55' Oil Cut mud, open 1 hour, shut in 15 minutes,
BHP Zero. Weak Blow throughout test.

DST #2 - 3791-3803 - 65' Muddy water, open 1 hour, shut in 15 minutes,
BHP 880. Weak blow throughout test.

RECEIVED
STATE CORPORATION COMMISSION

MAR 31 1953

CONSERVATION DIVISION
Topeka, Kansas

STATE OF KANSAS

COUNTY OF SEDGWICK

ss

I, the undersigned, being duly sworn on oath state that the above and within statement is a true and correct record and log of the well drilled on the location above-described, to the best of my knowledge and belief.

W. H. Beardmore

Subscribed and sworn to before me this 30th day of March, 1953.

Leonard P. Tolle
Notary Public

My Commission Expires:
January 28, 1956

