


STATE OF KANSAS
STATE CORPORATION COMMISSION

15-009-00221 - 0000
WELL PLUGGING RECORD

Give All Information Completely
Make Required Affidavit
Mail or Deliver Report to:
Conservation Division
State Corporation Commission
800 Biting Building
Wichita, Kansas

NORTH

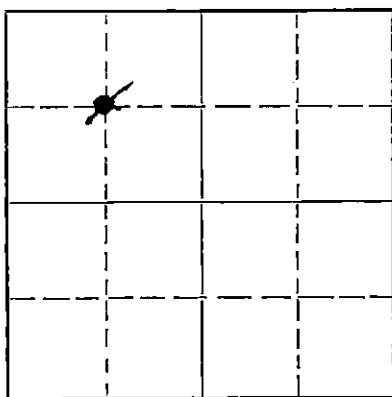

Locate well correctly on above
Section Plat

Barton County. Sec. 4 Twp. 16 Rge. (E) 12 (W)
Location as "NE/CNW/SW" or footage from lines NW NW SW
Lease Owner Fleming & Woodman Drlg., Co.
Lease Name Polzin Well No. 1
Office Address P. O. Box 387, Hoisington, Kansas.
Character of Well (completed as Oil, Gas or Dry Hole) Oil
Date well completed 7-31-1953 19 53
Application for plugging filed 12-27th, 19 53
Application for plugging approved Dec 30th, 19 53
Plugging commenced Jan 2nd, 19 54
Plugging completed Jan 8th, 19 54
Reason for abandonment of well or producing formation Depleted

If a producing well is abandoned, date of last production 12-1st, 19 53
Was permission obtained from the Conservation Division or its agents before plugging was commenced? Yes

Name of Conservation Agent who supervised plugging of this well Red Horner
Producing formation Arbuckle Depth to top 3320 Bottom 3330 Total Depth of Well 3330 Feet
Show depth and thickness of all water, oil and gas formations.

OIL, GAS OR WATER RECORDS

CASING RECORD

FORMATION	CONTENT	FROM	TO	SIZE	PUT IN	PULLED OUT
Dodge	Water	2972	2999	8 5/8"	115	None
Douglas Sand	"	2997	3002	5 1/2"	3321	2549
Brown Lime	"	3042	3052			
K.C. Lime	"	3052	3320			
Arbuckle	Oil & Water	3320	3330			

Describe in detail the manner in which the well was plugged, indicating where the mud fluid was placed and the method or methods used in introducing it into the hole. If cement or other plugs were used, state the character of same and depth placed, from _____ feet to _____ feet for each plug set.

Plugged back with crushed rock to 3210', dumped 5 sacks cement at 3210', with dump bailer. Top of cement 3175'. Filled hole with mud to 200', set rock bridge, dumped 30 sacks cement. Top of cement 95'. Filled hole with mud to 35', set rock bridge and dumped 10 sacks cement with dump bailer for cap.

(If additional description is necessary, use BACK of this sheet)

Name of Plugging Contractor Miller Casing Pulling Company
Address P. O. Box 711, Great Bend, Kansas.

STATE OF Kansas, COUNTY OF Barton, ss.
E. E. Fleming (owner or operator) of the above-described well, being first duly sworn on oath, says: That I have knowledge of the facts, statements, and matters herein contained and the log of the above-described well as filed and that the same are true and correct. So help me God.

(Signature) E. E. Fleming
P. O. Box 387, Hoisington, Kansas.
(Address)

SUBSCRIBED AND SWORN TO before me this 13 day of Febr, 1954

My commission expires June 22, 1955
M. Johnson Notary Public.

PLUGGING
FILE SEC 4 T 16 R 2W
BOOK PAGE 4 LINE 9

02-15-54

Fleming & Woodman and
Mid Plains Oil Corporation

No. 1 Polzin

NW NW SW 4-16S-12W
Barton County

Spud: 7-5-53
Comp: 7-16-53

Elevation 1878 KB

8 5/8 @ 145
5 1/2 @ 3321

surface soil	0-100
shale	115
shale and shells	145
shale	345
shale and red bed	690
red bed and shale	700
sand	715
sand and shale	755
shale	802
anhydrite	832
red bed and shale	850
shale and red bed	1005
shale and shells	1540
shale and lime	1620
lime	1670
shale and shells	1750
lime and shale	1810
shale and shells	2020
lime and shale	2145
shale and shells	2220
shale and shells	2710
shale and lime	2985
lime	3320
dolomite	3330
Total depth	3330

STATE OF KANSAS)
) SS:
COUNTY OF SEDGWICK)

I, K. T. Woodman, declare that to the best of my knowledge the foregoing is true.

K. T. Woodman

Subscribed and sworn to before me, a notary public, this 17th day of July, 1953.

Anna E. Raab
Notary Public

My commission expires
July 16, 1955.

PLUGGING
FILE SEC 4 T 16 S 12W
PAGE 4 LINE 9