

WELL PLUGGING RECORD

STATE OF KANSAS
STATE CORPORATION COMMISSION

Give All Information, Completely
Make Required Affidavit
Mail or Deliver Report to:
Conservation Division
State Corporation Commission
800 Bittling Building
Wichita, Kansas

FORMATION PLUGGING RECORD

Strike out upper line
when reporting plug-
ging of formations.

Stafford County. Sec. 29 Twp. 22 Rge. (E) 11 (W)

Location as "NE 1/4 NW 1/4 SW 1/4" or footage from lines. NW 1/4 NE 1/4 NW 1/4

Lease Owner Musgrove Petroleum Corporation

Lease Name Nolte Well No. 1

Office Address 407 K.F.H. Bldg., Wichita 2, Kansas

Character of Well (completed as Oil, Gas or Dry Hole) Dry Hole

Date well completed 11-12 19 48


Application for plugging filed (Via Telephone) 11-12 19 48

Application for plugging approved 11-13 19 48

Plugging commenced 11-13 19 48

Plugging completed 11-13 19 48

Reason for abandonment of well or producing formation Dry Hole

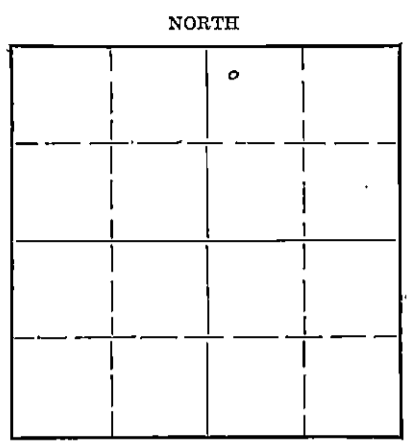

Locate well correctly on above Section Plat

If a producing well is abandoned, date of last production 19

Was permission obtained from the Conservation Division or its agents before plugging was commenced? Agent

Name of Conservation Agent who supervised plugging of this well C. D. Stough

Producing formation Depth to top Bottom Total Depth of Well 3639 Feet

Show depth and thickness of all water, oil and gas formations.

OIL, GAS OR WATER RECORDS

CASING RECORD

Formation	Content	From	To	Size	Put In	Pulled Out

Describe in detail the manner in which the well was plugged, indicating where the mud fluid was placed and the method or methods used in introducing it into the hole. If cement or other plugs were used, state the character of same and depth placed, from feet to feet for each plug set.

Filled hole with heavy mud to 266'.
Set a wooden plug.
Filled with 15 sacks of cement.
Filled with heavy mud to within 25' of top of hole.
Ran another wooden plug.
Filled with 10 sacks of cement to top of hole.

12-18-48

RECEIVED
 Cons. Div.
 DEC 18 1948
 STATE CORPORATION
 COMMISSION
 KANSAS

(If additional description is necessary, use BACK of this sheet)

Correspondence regarding this well should be addressed to Musgrove Petroleum Corporation
 Address 407 K.F.H. Building
Wichita 2, Kansas

STATE OF KANSAS, COUNTY OF SEDGWICK, ss.

P. C. Musgrove (owner or operator) of the above-described well,
 being first duly sworn on oath, says: That I have knowledge of the facts, statements, and matters herein contained and the log of the above-described well as filed and that the same are true and correct. So help me God.

(Signature) *P. C. Musgrove*
407 K.F.H. Bldg., Wichita 2, Kansas
 (Address)

SUBSCRIBED AND SWORN to before me this 17th day of December, 19 48

Madeline J. Ireland
 Notary Public.

My commission expires December 5, 1951

PLUGGING
 FILE SEC 29 T 22 R 11W
 BOOK PAGE 74 LINE 26

CONTRACTOR'S WELL LOGOperator Musgrove Petroleum Corp. Farm Name Nolte No. ILocation NW $\frac{1}{4}$ NE $\frac{1}{4}$ NW $\frac{1}{4}$ Sec. 29-22-11W.pool Name Richardson County Stafford State KansasCommencement Date December 2, 1948 Completion Date December 13, 1948

LOG OF WELL

Elevation 1832'

All measurements from the top of rotary bushing.

DEPTH FROM	TO	FORMATION	DEVIATION FROM VERTICAL	REMARKS:
0	110	Sand		
110	265	Shale-Red Bed		
265	500	Red Bed-Shale		
500	655	Shale-Red Bed		
655	680	Anhydrite		
680	1040	Shale-Shells	1000' - 0°	
1040	1440	Shale-Shells		
1440	1555	Shale-Lime	1500' - 0°	
1555	1760	Lime-Shale		
1760	1910	Lime-Shale		
1910	2085	Lime-Shale	2000' - 0°	
2085	2240	Shale-Lime		
2240	2385	Shale-Lime		
2385	2570	Shale-Lime	2500' - 0°	
2570	2730	Shale-Lime		
2730	2875	Shale		
2875	2945	Lime-Shale		
2945	3060	Lime		
3060	3130	Lime		
3130	3210	Lime-Shale		
3210	3285	Lime-Shale		
3285	3330	Lime		
3330	3400	Lime		
3400	3460	Lime		
3460	3495	Lime		
3495	3555	Lime		
3555	3590	Lime		
3590	3619	Lime		
3619	3629	Lime		
3629	3639	Lime		

CASING LEFT IN HOLE AFTER COMPLETION

Set 266.89' (12 jts.) 8-5/8" OD Surface Casing.


STATE OF KANSAS, COUNTY OF SEDGWICK, ss.

The undersigned certifies that to the best of his knowledge and belief, the above facts are true and correct.

C-G DRILLING COMPANY, Inc.

By R. A. Cook, President

Subscribed and sworn to before me this 14th day of December, 1948.

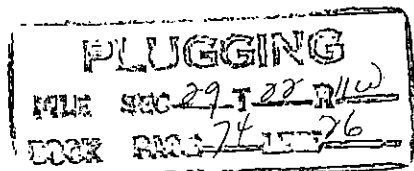My commission expires:
June 25, 1951Vicky [Signature]
Notary PublicDEC 18 1948
STATE COOPERATION
COMMISSION
KANSAS