


STATE OF KANSAS
STATE CORPORATION COMMISSION

WELL PLUGGING RECORD

Give All Information Completely
Make Required Affidavit
Mail or Deliver Report to:
Conservation Division
State Corporation Commission
800 Bitting Building
Wichita, Kansas

NORTH

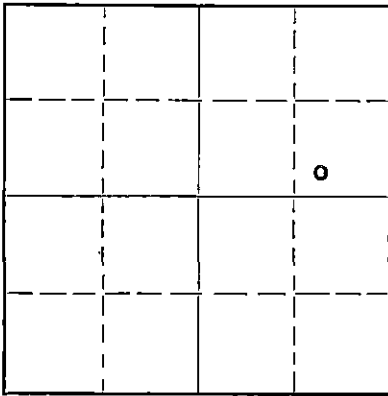

Locate well correctly on above
Section Plat

Stafford County. Sec. 29 Twp. 22 Rge. 11 (E) 11 (W)
Location as "NE/CNW $\frac{1}{4}$ SW $\frac{1}{4}$ " or footage from lines SW $\frac{1}{4}$ SE $\frac{1}{4}$ NE $\frac{1}{4}$
Lease Owner G. W. Keyes Drilling Co.
Lease Name Nolte Well No. 1
Office Address Box 92, Ellinwood, Kansas
Character of Well (completed as Oil, Gas or Dry Hole) Dry Hole
Date well completed 4-12-51 19
Application for plugging filed 5-25-51 19
Application for plugging approved 5-25-51 19
Plugging commenced 5-30-51 19
Plugging completed 5-30-51 19
Reason for abandonment of well or producing formation Dry Hole

If a producing well is abandoned, date of last production 19
Was permission obtained from the Conservation Division or its agents before plugging was commenced? Yes

Name of Conservation Agent who supervised plugging of this well C. D. Stough
Producing formation Depth to top Bottom Total Depth of Well 3610 Feet
Show depth and thickness of all water, oil and gas formations.

OIL, GAS OR WATER RECORDS

CASING RECORD

Formation	Content	From	To	Size	Put In	Pulled Out
Surface Pipe		0	182'	8-5/8"	182'	182'
		0	3631'	5 1/2"	3631'	2838'

Describe in detail the manner in which the well was plugged, indicating where the mud fluid was placed and the method or methods used in introducing it into the hole. If cement or other plugs were used, state the character of same and depth placed, from feet to feet for each plug set.

Filled hole with rock from 3580' to 3275' and cemented with five sacks cement. Mudded hole with heavy mud to 185', set 10' rock bridge and cemented with 15 sacks cement. Mudded hole to 35' and cemented with ten sacks, cement returning to base of cellar.

(If additional description is necessary, use BACK of this sheet)


Correspondence regarding this well should be addressed to G. W. Keyes Drilling Co.
Address Ellinwood, Kansas

STATE OF KANSAS, COUNTY OF BARTON, ss.
I, Edw. H. Isern, Part Owner (employee of owner, or owner or operator) of the above-described well, being first duly sworn on oath, says: That I have knowledge of the facts, statements, and matters herein contained and the log of the above-described well as filed and that the same are true and correct. So help me God.

(Signature) Edw. H. Isern
Ellinwood, Kansas (Address)

SUBSCRIBED AND SWORN to before me this 27th day of June, 1951
George A. Meyer Notary Public

My commission expires Feb. 10, 1955.

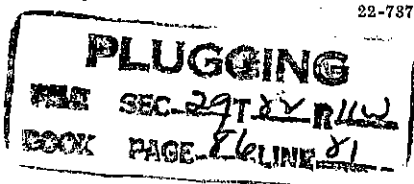

22-7377-5 CON 4-49-10M JUN 28 1951

6-28-51

WELL LOG

G. W. KEYES DRILLING CO., OWNER - Nolte #1
 SW $\frac{1}{4}$ SE $\frac{1}{4}$ NE $\frac{1}{4}$ Section 29, Township 22S, Range 11W
 Stafford County, Kansas

Elevation: 1824' DF

Figures indicate bottom of formation
 0 to 25 shale

Pipe Record:

8- $\frac{5}{8}$ " set @ 182'
 5- $\frac{1}{2}$ " set @ 3631'

35 sand
 75 sand and shale
 100 shells
 165 shale and shells
 555 red bed
 587 anhydrite

Tops, corrected 2' to derrick floor

Heebner 3110'
 Brown lime 3238'
 Lansing 3262'
 Conglomerate 3551'
 Simpson 3581'

1210 shale and shells
 1410 salt
 1805 shale and shells
 2845 sand and shale
 1970 lime and shale
 2190 shale and shells
 2290 lime and shale
 2500 shale and shells
 2585 lime and shale
 2660 shale, lime & shells
 2745 shale and shells
 3075 lime and shale
 3110 lime
 3140 shale and lime
 3165 lime and shale
 3240 shale and lime
 3305 brown lime
 3553 lime
 3583 cherty conglomerate
 3588 simpson
 3595 simpson sand
 3636 shale
 3640 sand
 3640 Total Rotary Depth

Rotary commenced 3-17-51
 " completed 3-27-51

Cable Tools commenced 4-2-51
 " " completed 4-12-51

CABLE TOOL WORK

Moved in, rigged up, drilled cement and cleaned out hole to total rotary depth. Made 1' of new hole. Ran Gamma Ray, acidized, tested, plugged back to 3580'. Perforated, acidized, tested, reacidized and tasted.

Total plug-back depth 3580' D & A
 STATE OF KANSAS COMMISSION

STATE OF KANSAS)
 COUNTY OF BARTON) SS

JUN 28 1951

I, M. M. Shropshire, Tool Pusher on the above-described well, being first duly sworn on oath, declare that I have knowledge of the facts, statements and matters herein contained pertaining to the log of the above-described well, as filed, and that the same are true and correct.

PLUGGING
 FILE SEC-29T 22R 11W
 BOOK PAGE 86 LINE 21

M. M. Shropshire

Subscribed and Sworn to before me this 15th day of June, 1951

My commission expires Feb. 10, 1955.

George A. Meyer
 Notary Public