

1 040334

10-7

API NUMBER 15-185-22,600-0000

To: STATE CORPORATION COMMISSION
CONSERVATION DIVISION - PLUGGING SECTION
200 COLORADO DERBY BUILDING
WICHITA, KANSAS 67202

C S/2 SE, SEC. 29, T 22 S, R 11 W/E
660 feet from S section line
1320 feet from E section line

TECHNICIAN'S PLUGGING REPORT

Operator License # 5107

Lease Name Spangenberg Well # 1-29

Operator: H-30, Inc.

County Stafford 119.60

Name & Address 251 North Water, Suite 10
Wichita, KS 67202

Well Total Depth 3680 feet

Conductor Pipe: Size feet

Surface Casing: Size 8 5/8 feet 273

Abandoned Oil Well Gas Well Input Well SWD Well D&A y

Other well as hereinafter indicated

Plugging Contractor H-30, Drilling License Number 5107

Address 251 North Water, Suite 10, Wichita, KS 67202

Company to plug at: Hour: 12 a.m. Day: 7 Month: 10 Year: 19 89

Plugging proposal received from Mike Tharp

(company name) H-30 (phone) 316-263-2043

were: to fill hole with heavy mud and spot cement through drill pipe Anhydrite 550-590'

1st plug at 3590' with 40 sx cement, 2nd plug at 720' with 50 sx cement,

3rd plug at 300' with 40 sx cement, 4th plug at 40' with 10 sx cement,

5th plug to circulate rathole with 15 sx cement.

Plugging Proposal Received by Steve Pfeifer (TECHNICIAN)

Plugging Operations attended by Agent?: All Part None X

Operations Completed: Hour: 2:15 a.m. Day: 7 Month: 10 Year: 19 89

ACTUAL PLUGGING REPORT 1st plug at 3590' with 40 sx cement,

2nd plug at 720' with 50 sx cement,

3rd plug at 300' with 40 sx cement,

4th plug at 40' with 10 sx cement,

5th plug to circulate rathole with 15 sx cement.

Remarks: Used 60/40 Pozmix 6% gel by Allied.

(If additional description is necessary, use BACK of this form.)

INVOICED

DATE 10-13-89

INV. NO. 26139

Signed Stephen J. Pfeifer (TECHNICIAN)

FORM MUST BE TYPED
FORM C-1 12/88

State of Kansas 15-185-22,600-0000
NOTICE OF INTENTION TO DRILL

FORM MUST BE SIGNED
ALL BLANKS MUST BE FILLED

Must be approved by the K.C.C. five (5) days prior to commencing well

Expected Spud Date August 21, 1989
month day year

C. S/2 SE Sec 29, Twp 22 S, Rg 11 X East West

OPERATOR: License # 5107
Name: H-30, Inc.
Address: 251 No. Water, Suite #10
City/State/Zip: Wichita, KS 67202
Contact Person: Jeffrey A. Burk
Phone: (316) 263-2043

660' feet from South line of Section
1320' feet from East line of Section
(Note: Locate well on Section Plat Below)

CONTRACTOR: License #: 5107
Name: H-30 Drilling

County: Stafford
Lease Name: Spangenberg Well #: 1-29
Field Name: Wildcat Richardson
Is this a Prorated Field? yes X no
Target Formation(s): Lansing, Simpson, Arbuckle
Nearest lease or unit boundary: 660'
Ground Surface Elevation: 1830' est. feet MSL
Domestic well within 330 feet: yes X no
Municipal well within one mile: yes X no
Depth to bottom of fresh water: 180'
Depth to bottom of usable water: 180'
Surface Pipe by Alternate: X 1
Length of Surface Pipe Planned to be set: 250' (+-)
Length of Conductor pipe required: NA
Projected Total Depth: 3750'
Formation at Total Depth: Arbuckle
Water Source for Drilling Operations:
X well farm pond other
DWR Permit #: applied for permit
Will Cores Be Taken? yes X no
If yes, proposed zone: NA

Well Drilled For: Well Class: Type Equipment:
X Oil Inj Infield X Mud Rotary
Gas Storage Pool Ext. Air Rotary
OAWO Disposal X Wildcat Cable
Seismic: # of Holes

If OAWO: old well information as follows:
Operator:
Well Name:
Comp. Date: Old Total Depth

Directional, Deviated or Horizontal wellbore? yes X no
If yes, total depth location: NA


AFFIDAVIT

200' Alt. I Req.

PUSHER Mike Tharp
TD 3680 Drilled into Arb. 90' FORMATION Arb.
SURFACE PIPE 8 5/8 @ 273
ANHYDRITE 550 - 590 ELEVATION
STARTING TIME & DATE 12:00 AM 10-7-89
COMPLETION TIME & DATE 2:15 AM 10-7-89
1st PLUG @ 3590 FT. WI 40 SX
2nd PLUG @ 120 FT. WI 50 SX
3rd PLUG @ 300 FT. WI 40 SX
4th PLUG @ 40 FT. WI 10 SX
RAT HOLE CIRCULATED WI 15 SX
MOUSE HOLE CIRCULATED WI 10 105X SX
WATER WELL PLUGGED WI Fill w/ cement SX
CEMENT COMPANY Allied
TECHNICIAN S.P.
TYPE OF CEMENT 60/40/6 10

SPUD 9-29-89
250' of 8 5/8
W.W. YES.
S.P.

RECEIVED
STATE CORPORATION COMMISSION
OCT 12 1989
CONSERVATION DIVISION
Wichita, Kansas

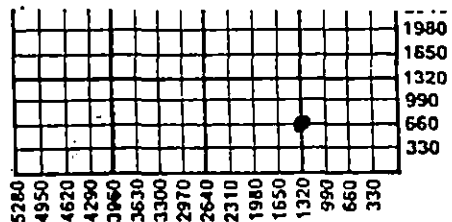

Spud date: Agent:

REMEMBER TO:

- File Drill Pit Application (form CDP-1) with Intent to Drill;
- File Completion Form ACO-1 within 120 days of spud date;
- File acreage attribution plat according to field proration orders;
- Notify appropriate district office 48 hours prior to workover or re-entry;
- Submit plugging report (CP-4) after plugging is completed;
- Obtain written approval before disposing or injecting salt water.