


WELL PLUGGING RECORD

Give All Information Completely
Make Required Affidavit
Mail or Deliver Report to:
Conservation Division
State Corporation Commission
212 North Market, Insurance Bldg.
Wichita, Kansas

Kearny County, Sec. 28 Twp. 21S Rge. (E) 35(W)

Location as "NE/CNW%SW%" or footage from lines 100' E. of C-NE-SW
Lease Owner R. W. Lange
Lease Name Coy Well No. 2
Office Address Box 1034, Garden City, Kansas 67846
Character of Well (completed as Oil, Gas or Dry Hole) Dry Hole
Date well completed November 18, 1975 19
Application for plugging filed November 18, 1975 19
Application for plugging approved November 18, 1975 19
Plugging commenced November 18, 1975 19
Plugging completed November 18, 1975 19
Reason for abandonment of well or producing formation Dry Hole

NORTH

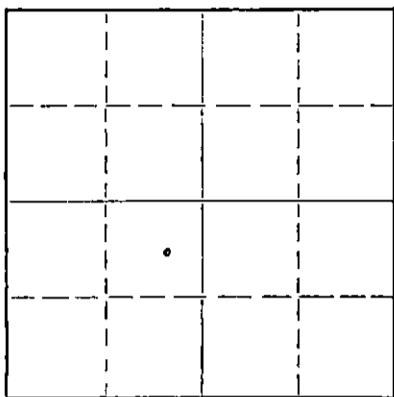

Locate well correctly on above Section Plat

If a producing well is abandoned, date of last production _____ 19
Was permission obtained from the Conservation Division or its agents before plugging was commenced? yes

Name of Conservation Agent who supervised plugging of this well Mr. Clarence Thomas
Producing formation None Depth to top _____ Bottom _____ Total Depth of Well 5100 Feet
Show depth and thickness of all water, oil and gas formations.

OIL, GAS OR WATER RECORDS

CASING RECORD

FORMATION	CONTENT	FROM	TO	SIZE	PUT IN	PULLED OUT
Sand	Water	100	522	8 5/8"	539'	0

Describe in detail the manner in which the well was plugged, indicating where the mud fluid was placed and the method or methods used in introducing it into the hole. If cement or other plugs were used, state the character of same and depth placed, from _____ feet to _____ feet for each plug set.

Well was plugged as follows:

- Mud 5100' to 900'
- 50 sx. cement plug 900' to 800'
- Mud 800' to 500'
- 35 sx. cement plug 500' to 400'
- Mud 400' to 40'
- 15 sx. cement plug 40' to 15'

RECORDED
STATE CORPORATION COMMISSION

JAN 14 1976

1-14-76

STATE OF KANSAS
Wichita, Kansas

(If additional description is necessary, use BACK of this sheet)

Name of Plugging Contractor Halliburton Co.
Address Liberal, Kansas

STATE OF Texas, COUNTY OF Hutchinson, ss.
Roy W. Reese (employee of owner) or (owner or operator) of the above-described well, being first duly sworn on oath, says: That I have knowledge of the facts, statements, and matters herein contained and the log of the above-described well as filed and that the same are true and correct. So help me God.

(Signature) Roy W. Reese
Roy W. Reese
Box 910, Borger, Texas 79007
(Address)

SUBSCRIBED AND SWORN TO before me this 8th day of December, 1975

Wanda L. Goode
Wanda L. Goode
Notary Public.

My commission expires June 1, 1977



R. W. LANGESection 28-21S-35W
Kearny County, Kansas

OPERATIONS COMMENCED: 11/4/75

OPERATIONS COMPLETED: 11/18/75

DRILLERS LOG

11/4/75	0 - 127	Sand, Shale
11/5/75	127 - 545	Sand, Shale
11/6/75	545 - 2032	Sand, Shale
11/7/75	2032 - 2690	Shale
11/8/75	2690 - 3166	Shale
11/9/75	3166 - 3499	Lime, Shale
11/10/75	3499 - 3872	Lime, Shale
11/11/75	3872 - 4210	Lime, Shale
11/12/75	4210 - 4538	Lime, Shale
11/13/75	4538 - 4575	Lime, Shale
11/14/75	4575 - 4665	Lime, Shale
11/15/75	4665 - 4864	Lime, Shale
11/16/75	4864 - 5052	Lime, Shale
11/17/75	5052 - 5100	Lime

CASING RECORD

11/5/75 Ran 13 Jts. of 8 5/8", 20# new casing, 541'. Set at 539'. Cemented with 150 Sks. 35-65 Pozmix, 6% Gel and 2% c.c., and 150 Sks. Class H, 3% c.c.

11/18/75 Plugged with 50 Sks. at 900'; 35 Sks. at 500'; 15 Sks. at 0 - 40'; 3 Sks. in rat hole.

RECEIVED
STATE CORPORATION COMMISSION

JAN 14 1976

CONSERVATION DIVISION
Wichita, Kansas