


Give All Information Completely  
Make Required Affidavit  
Mail or Deliver Report to:  
Conservation Division  
State Corporation Commission  
211 No. Broadway  
Wichita, Kansas

NORTH

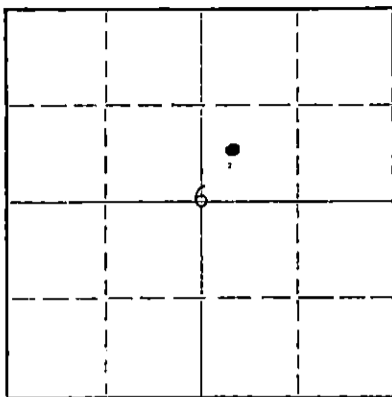

Locate well correctly on above  
Section Plat

Barton County, Sec. 6 Twp. 16 S. Rge. ~~12~~ 12 (W)  
Location as "NE/CNW/SW" or footage from lines 330' FWL & 590' FSL NE/4  
Lease Owner: Beacon Resources Corporation  
Lease Name: Staudinger Well No. 2  
Office Address: 412 Union Center, Wichita, Kansas  
Character of Well (completed as Oil, Gas or Dry Hole) Dry Hole  
Date well completed November 17 19 67  
Application for plugging filed November 17 19 67  
Application for plugging approved November 17 19 67  
Plugging commenced November 17 19 67  
Plugging completed November 17 19 67  
Reason for abandonment of well or producing formation Dry Hole

If a producing well is abandoned, date of last production 19\_\_\_\_  
Was permission obtained from the Conservation Division or its agents before plugging was commenced? Yes

Name of Conservation Agent who supervised plugging of this well Donald Truan, Russell, Kansas  
Producing formation \_\_\_\_\_ Depth to top \_\_\_\_\_ Bottom \_\_\_\_\_ Total Depth of Well 3172 Feet  
Show depth and thickness of all water, oil and gas formations.

OIL, GAS OR WATER RECORDS

CASING RECORD

FORMATION	CONTENT	FROM	TO	SIZE	PUT IN	PULLED OUT

Describe in detail the manner in which the well was plugged, indicating where the mud fluid was placed and the method or methods used in introducing it into the hole. If cement or other plugs were used, state the character of same and depth placed, from \_\_\_\_\_ feet to \_\_\_\_\_ feet for each plug set.

Filled hole with mud up to 350' from surface; set plug and 25 sacks cement.  
Filled hole to 40' with mud; set plug and 10 sacks of cement;  
Put two sacks cement in rat hole.

RECEIVED  
NOV 21 1967  
CONSERVATION DIVISION  
Wichita, Kansas

(If additional description is necessary, use BACK of this sheet)

Name of Plugging Contractor Halliburton Company  
Address Great Bend, Kansas

STATE OF Kansas, COUNTY OF Sedgwick, ss.  
F. S. Woodside, Jr., contractor on (employee of owner) or (owner or operator) of the above-described well, being first duly sworn on oath, says: That I have knowledge of the facts, statements, and matters herein contained and the log of the above-described well as filed and that the same are true and correct. So help me God.

(Signature) F. S. Woodside, Jr.  
427 Union Center, Wichita, Kansas  
(Address)

SUBSCRIBED AND SWORN TO before me this 20th day of November, 19 67

My commission expires February 28, 1971

Mary L. Lawrence  
Mary L. Lawrence Notary Public.

ROTARY DRILLING LOG

Operator: Beacon Resources Corporation  
#2 Staudinger  
330' FWL & 590' FSL NE/4 6-16S-12W  
Barton County, Kansas

Contractor: Omega Drilling, Inc.  
Commenced: November 13, 1967  
Completed: November 18, 1967

Casing Record:  
8 5/8" surface casing  
cemented at 400' with 275  
sacks cement.

FORMATIONS


405	Clay and shale
710	Shale and sand
827	Shale
854	Anhydrite
1170	Red bed and shale
1784	Shale and shells
3090	Lime and shale
3172	Lime
3172	Rotary Total Depth

RECEIVED  
STATE CORPORATION COMMISSION  
NOV 21 1967  
CONSERVATION DIVISION  
Wichita, Kansas

We certify that the above log is true and correct to the best of our knowledge and belief.

OMEGA DRILLING, INC.

By

  
F. S. Woodside, Jr.  
President

Subscribed and sworn to before me, a Notary Public, in and for the State of Kansas, County of Sedgwick, this 20th day of November, 1967.

  
Mary L. Lawrence, Notary Public

My commission expires February 28, 1971.