


STATE OF KANSAS  
STATE CORPORATION COMMISSION

Give All Information Completely  
Make Required Affidavit  
Mail or Deliver Report to:  
Conservation Division  
State Corporation Commission  
212 North Market, Insurance Bldg.  
Wichita, Kansas

15-009-06717-0000  
WELL PLUGGING RECORD

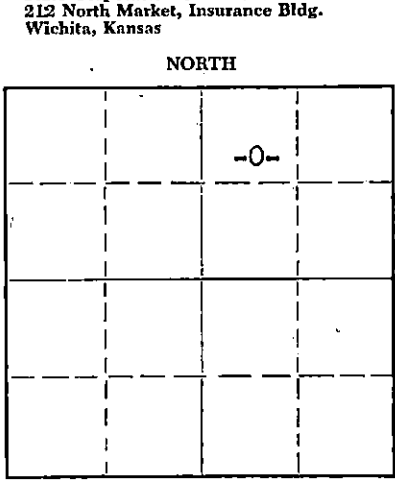

Locate well correctly on above Section Plat

BARTON County. Sec. 6 Twp. 16 Rge. 12 (E) (W) X  
Location as "NE/CNW%SW%" or footage from lines SE NW NE  
Lease Owner MORRIS GARVIN  
Lease Name STAUDINGER Well No. #1  
Office Address ST. JOHN, KANSAS  
Character of Well (completed as Oil, Gas or Dry Hole) DRY HOLE  
Date well completed OCTOBER 12 1961  
Application for plugging filed OCTOBER 12 1961  
Application for plugging approved OCTOBER 12 1961  
Plugging commenced OCTOBER 12 1961  
Plugging completed OCTOBER 12 1961  
Reason for abandonment of well or producing formation DRY HOLE

If a producing well is abandoned, date of last production 19  
Was permission obtained from the Conservation Division or its agents before plugging was commenced? YES

Name of Conservation Agent who supervised plugging of this well DONALD TRUAN, RUSSELL, KANSAS  
Producing formation \_\_\_\_\_ Depth to top \_\_\_\_\_ Bottom \_\_\_\_\_ Total Depth of Well 3323 Feet  
Show depth and thickness of all water, oil and gas formations.

OIL, GAS OR WATER RECORDS					CASING RECORD	
FORMATION	CONTENT	FROM	TO	SIZE	PUT IN	PULLED OUT
		0	545'	8-5/8"		

Describe in detail the manner in which the well was plugged, indicating where the mud fluid was placed and the method or methods used in introducing it into the hole. If cement or other plugs were used, state the character of same and depth placed, from \_\_\_\_\_ feet to \_\_\_\_\_ feet for each plug set.

HOLE WAS FILLED WITH ROTARY MUD TO 350' FROM TOP.  
PLUG AND 1/4 SXS HULLS TO TOP OF FLUID. CEMENTED W/ 20 SXS COMMON CEMENT THROUGH DRILL PIPE.  
MUD TO 35' FROM TOP. PLUG AND 1/4 SXS OF HULLS. CEMENTED W/ 10 SXS OF COMMON CEMENT.  
JOB COMPLETED AT 6:00 PM 10/12/61

**RECEIVED**  
STATE CORPORATION COMMISSION  
OCT 16 1961  
CONSERVATION DIVISION  
Wichita, Kansas  
10-16-61


(If additional description is necessary, use BACK of this sheet)  
Name of Plugging Contractor \_\_\_\_\_  
Address \_\_\_\_\_

STATE OF KANSAS COUNTY OF BARTON ss.  
F. L. COPELAND (employee or owner) or (owner or operator) of the above-described well, being first duly sworn on oath, says: That I have knowledge of the facts, statements, and matters herein contained and the log of the above-described well as filed and that the same are true and correct. So help me God.

(Signature) F. L. Copeland  
925 PATTON ROAD, GREAT BEND, KANSAS  
(Address)

SUBSCRIBED AND SWORN to before me this 13TH day of OCTOBER, 1961  
JANICE M. BECKER  
JANICE M. BECKER Notary Public.

My commission expires JUNE 27, 1965

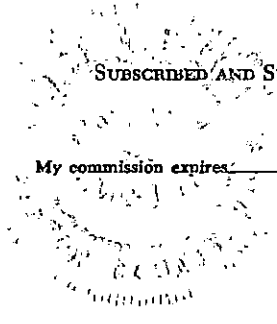

DRILLERS LOG

#1 STAUDINGER

CASING RECORD:  
12 JTS 8-5/8"  
20# PIPE.

COMPANY: MORRIS GARVIN  
CONTRACTOR: WESTERN PETROLEUM Co., INC.

DESCRIPTION: SE NW NE  
SECTION 6-T16S-R12W  
BARTON COUNTY, KANSAS

TOTAL DEPTH:  
3323'

COMMENCED: OCTOBER 3, 1961  
COMPLETED: OCTOBER 12, 1961

ELEVATION: 1858 DF  
1861 KB

FORMATION	FROM	TO	REMARKS
CLAY AND POST ROCK	0	50	SPUD @ 1:50 PM 10/3/61. RAN 12 JTS 8-5/8" 20# NEW PIPE. SET @ 545' w/ 250 SXS POZMIX w/ HA 5 ADDED. PLUG DOWN @ 5:15 AM 10/4/61
ROCK SAND	50	167	
SAND AND SHALE	167	333	
SAND	333	442	
SAND AND SHALE	442	500	
RED BED AND SHALE	500	809	
ANHYDRITE	809	834	
SHALE SHELLS	834	1050	
SHALE AND SHELLS	1050	1548	
LIME AND SHALE	1548	1573	
LIME	1573	1975	DST #1 2891 - 2985'. OP. 1 HR. WEAK BLW 30" REC. 70' MUD w/ FEW OIL SPECKS IFP 70# FFP 105#, FBHP 765#/30"
LIME AND SHALE	1975	2325	DST #2 2979 - 3090'. OP. 1 HR. GOOD BLW. GTS 30". REC. 420' FLUID, 120' GM, 300' VSO & GCM. IFP 130#, FFP 215# IBHP 370# 20", FBHP 360#/45"
SHALE AND LIME	2325	2545	DST #3 3168 - 3250'. OP. 1 1/2 HRS. WEAK STEADY BLW. REC. 180' VISIBLE GAS, 75' MODERATELY O & GCM, IBHP 740#/20", FBHP 315#/40", IFP 60#, FFP 100#.
LIME AND SHALE	2545	3090	DST #4 3270 - 3314'. OP. 30". WEAK BLW 8". REC. 10' MUD. NS, IBHP 965#/20" FBHP 90#/20", IFP 0#, FFP 0#
LIME	3090	3323	DST #5 3314 - 19'. MIS-RUN
RTD	3323		DST #6 3271 - 3323'. OP. 1 HR. GOOD BLW THROUGHOUT. REC. 1280' MUDDY SULPHUR WTR. NS, IBHP 1050#/20, FBHP 1050#/20" IFP 130# FFP 600#
SAMPLE TOPS			
ANHYDRITE	809	1052	
HEEBNER	2952	-1091	
JATAN	3036	-1175	
LANSING	3047	-1186	
CONGLOMERATE	3296	-1435	
ARBUCKLE	3313	-1452	

**RECEIVED**  
STATE CORPORATION COMMISSION  
OCT 16 1961  
CONSERVATION DIVISION  
Wichita, Kansas

D & A

STATE OF KANSAS }  
COUNTY OF BARTON } SS

I, THE UNDERSIGNED, BEING DULY SWORN ON OATH, STATE THAT THE ABOVE STATEMENT AND LOG ARE TRUE AND A CORRECT RECORD AND LOG OF THE WELL DRILLED AT THE LOCATION ABOVE DESCRIBED.

WESTERN PETROLEUM CO., INC.

*F. L. Copeland*  
F. L. COPELAND, DRLG. SUPT.

SUBSCRIBED AND SWORN TO BEFORE ME THIS 13TH DAY OF OCTOBER, 1961

*Janice M. Becker*  
JANICE M. BECKER, NOTARY PUBLIC

MY COMMISSION EXPIRES: JUNE 27, 1965