


STATE OF KANSAS  
STATE CORPORATION COMMISSION

Give All Information Completely  
Make Required Affidavit  
Mail or Deliver Report to:  
Conservation Division  
State Corporation Commission  
800 Bittling Building  
Wichita, Kansas

WELL PLUGGING RECORD

15-009-06510-8888

NORTH

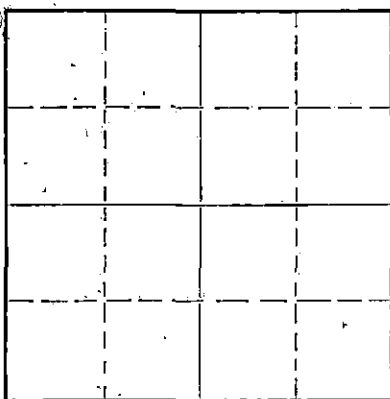

Locate well correctly on above Section Plat

Barton County, Sec. 6 Twp. 16 Rge. (E) 12 (W)  
Location as "NE/CNW/SW" or footage from lines SW SE NE  
Lease Owner Lee Phillips Oil Company  
Lease Name Staudinger "B" Well No. 3  
Office Address 1407 Union Nat'l. Bank Bldg., Wichita, Kansas  
Character of Well (completed as Oil, Gas or Dry Hole) Dry Hole  
Date well completed June 1 19 51  
Application for plugging filed July 3 19 51  
Application for plugging approved July 3 19 51  
Plugging commenced July 4 19 51  
Plugging completed July 13 19 51  
Reason for abandonment of well or producing formation Dry Hole

If a producing well is abandoned, date of last production 19  
Was permission obtained from the Conservation Division or its agents before plugging was commenced? Yes

Name of Conservation Agent who supervised plugging of this well C. D. Stough  
Producing formation Depth to top Bottom Total Depth of Well 3302 Feet  
Show depth and thickness of all water, oil and gas formations.

OIL, GAS OR WATER RECORDS

CASING RECORD

Formation	Content	From	To	Size	Put In	Pulled Out
				8-5/8"	446'	None
				5 1/2"	3302'	2832'

Describe in detail the manner in which the well was plugged, indicating where the mud fluid was placed and the method or methods used in introducing it into the hole. If cement or other plugs were used, state the character of same and depth placed, from feet to feet for each plug set.

Plugged back from 3130' to 3105' with sand, set rock bridge and dumped 5 sacks cement. Mudded up to 250', set rock bridge and dumped 15 sacks cement. Mudded on up to 30', set rock bridge and dumped 10 sacks cement.

(If additional description is necessary, use BACK of this sheet)

Correspondence regarding this well should be addressed to Lee Phillips Oil Company  
Address 1407 Union Nat'l. Bank Bldg., Wichita, Kansas

STATE OF KANSAS, COUNTY OF SEDGWICK, ss.  
L. E. Phillips, Jr. (employee of owner) or (owner or operator) of the above-described well,  
being first duly sworn on oath, says: That I have knowledge of the facts, statements, and matters herein contained and the log of the above-described well as filed and that the same are true and correct. So help me God.

(Signature) *L. E. Phillips, Jr.*  
1407 Union Nat'l. Bank Bldg., Wichita, Kansas.  
(Address)

SUBSCRIBED AND SWORN to before me this 30th day of July, 19 51.  
My commission expires October 4, 1953  
Wichita, Kansas

RECEIVED  
STATE CORPORATION COMMISSION  
JUL 31 1951  
CONSERVATION DIVISION  
PLUGGING  
FILE SEC 67-16-12  
BOOK PAGE 22 LINE 31  
Notary Public. *Hell A Salaman*  
07-31-51

