


STATE OF KANSAS
STATE CORPORATION COMMISSION

Give All Information Completely
Make Required Affidavit
Mail or Deliver Report to:
Conservation Division
State Corporation Commission
800 Bittling Building
Wichita, Kansas

15-009-15694-0000
WELL PLUGGING RECORD

Barton County, Sec. 6 Twp. 16 Rge. (E) 12 (W)
Location as "NE/CNW/SW" or footage from lines NW SE SW

Lease Owner Harry Gore
Lease Name Stull Well No. 3
Office Address 400 Brown Building, Wichita, Kansas
Character of Well (completed as Oil, Gas or Dry Hole) oil
Date well completed 2-1-51 19
Application for plugging filed 7-21-54 19
Application for plugging approved 7-22-54 19
Plugging commenced 8-19-54 19
Plugging completed 8-24 19 54
Reason for abandonment of well or producing formation oil exhausted

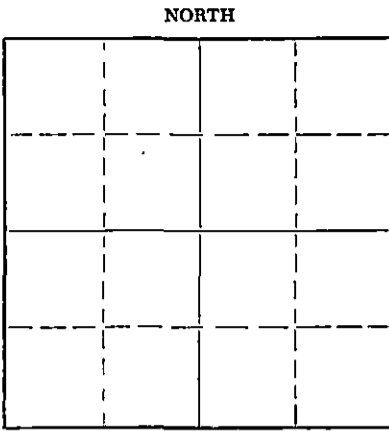

Locate well correctly on above
Section Flat

If a producing well is abandoned, date of last production _____ 19
Was permission obtained from the Conservation Division or its agents before plugging was commenced? yes

Name of Conservation Agent who supervised plugging of this well Warren H. Horner
Producing formation _____ Depth to top _____ Bottom _____ Total Depth of Well 3350 Feet
Show depth and thickness of all water, oil and gas formations.

OIL, GAS OR WATER RECORDS

CASING RECORD

FORMATION	CONTENT	FROM	TO	SIZE	PUT IN	PULLED OUT
				<u>5 1/2</u>	<u>3347</u>	<u>2473</u>
				<u>8-5/8</u>	<u>202</u>	<u>none</u>

Describe in detail the manner in which the well was plugged, indicating where the mud fluid was placed and the method or methods used in introducing it into the hole. If cement or other plugs were used, state the character of same and depth placed, from _____ feet to _____ feet for each plug set.

3369 to 3330 ft. Sand bridge
3330 to 3305 ft. 5 sks. cement
3305 to 200 ft. Mudded
200 to 190 ft. Rock bridge
190 to 155 ft. 15 sks. cement
155 to 30 ft. Mud
30 to Cellar 10 sks. cement

Name of Plugging Contractor R & S Pipe Pulling Co. (If additional description is necessary, use BACK of this sheet)
Address Box 192, Ellinwood, Kansas

STATE OF Kansas, COUNTY OF Sedgwick, ss.
Ralph Gore (~~Notary Public~~) or (owner or operator) of the above-described well, being first duly sworn on oath, says: That I have knowledge of the facts, statements, and matters herein contained and the log of the above-described well as filed and that the same are true and correct. So help me God.
(Signature) Ralph Gore

400 Brown Bldg., Wichita, Kansas
(Address)

SUBSCRIBED AND SWORN TO before me this 8th day of September, 19 54

My commission expires June 7, 1956

24-2675-S 2-52-20M

PLUGGING
FILE SEC 6 T 16 R 12 W
BOOK PAGE 50 LINE 15

RECEIVED
STATE CORPORATION COMMISSION
SEP - 9 1954
CONSERVATION DIVISION
Wichita, Kansas
Notary Public.
09-09-54

Veeder Supply & Dev'l. Co.



Cherryvale, Kansas

Drilled for Harry Gore Farm Stull No. #3 Depth 3350'
 Contractor The Veeder Supply & Development Co. Set 3347' of 5 1/2" Csg. Cemented with 150 sacks.
 Pipe Set 202' of 8-5/8" Csg. Cemented with 120 sx.
 Location NW SE SW Sec. 6 Twp. 16 Range 12
 Commenced 1-20-51 Completed 2-1-51 County Barton State Kansas

Soil-Clay Shale	0	150	150	Tops -	
Shale	150	200	50	Topeka Lime	- 2724
Shale Shells	200	505	305	Heebner Shale	- 2965
Red Bed	505	830	325	Lansing K.C.	- 3050
Anhydrite	830	860	30	Conglomerate	- 3322
Shale Shells	860	910	50	Arbuckle	- 3343
Shale Shells Salt	910	1500	590		
Shale Shells	1500	1565	65		
Lime Shale	1565	2300	735		
Lime Shells Shale	2300	2545	245		
Lime Shale	2545	2610	65		
Shale Shells	2610	2670	60		
Lime	2670	2960	290		
Lime Shale	2960	3055	95		
Lime	3055	3350	295		
Total Depth	3350'				

AFFIDAVIT

STATE OF KANSAS
MONTGOMERY COUNTY SS:

FLOYD W. HILD, of lawful age, being duly and solemnly sworn on oath says; I am a resident of Cherryvale, Montgomery, County, Kansas, and I hereby know and on oath state, that the above drilling log covering the Stull #3 Well, in Section 6-16-12, Barton County, Kansas, is true and correct. Further affiant saith not.

THE VEEDER SUPPLY & DEVELOPMENT COMPANY

By Floyd W. Hild

Subscribed and sworn to before me this 3rd day of February, 1951.

Leo Lawson
Notary Public

My Commission Expires: July 11, 1952

PLUGGING
FILE SEC 6 T 16 R 22 W
BOOK 50 PAGE 15

RECEIVED
STATE CORPORATION COMMISSION
CONSERVATION DIVISION
Wichita, Kansas