


STATE OF KANSAS
STATE CORPORATION COMMISSION

Give All Information Completely
Make Required Affidavit
Mail or Deliver Report to:
Conservation Division
State Corporation Commission
800 Bittling Building
Wichita, Kansas

15-009-15688-0000
WELL PLUGGING RECORD

NORTH

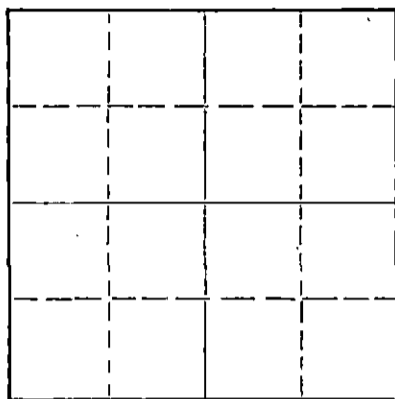

Locate well correctly on above
Section Plat

Barton County, Sec. 6 Twp. 16 Rge. 12 (W)

Location as "NE/CNW/SW" or footage from lines NE NE NE
Lease Owner Frank G. Wood Drilling Co.
Lease Name Staudinger Well No. 1
Office Address Box 619, Great Bend, Kansas
Character of Well (completed as Oil, Gas or Dry Hole) Oil
Date well completed March 10 19 55
Application for plugging filed November 29 19 55
Application for plugging approved December 1 19 55
Plugging commenced December 13 19 55
Plugging completed December 14 19 55
Reason for abandonment of well or producing formation Not commercial

If a producing well is abandoned, date of last production October 27, 19 55
Was permission obtained from the Conservation Division or its agents before plugging was commenced? Yes

Name of Conservation Agent who supervised plugging of this well R. M. Brundage
Producing formation Kansas City Depth to top 3024 Bottom 3294 Total Depth of Well 3300 Feet
Show depth and thickness of all water, oil and gas formations.

OIL, GAS OR WATER RECORDS

CASING RECORD

FORMATION	CONTENT	FROM	TO	SIZE	PUT IN	PULLED OUT
				8 5/8"	445'	None
				5 1/2"	3295'	2682'

Describe in detail the manner in which the well was plugged, indicating where the mud fluid was placed and the method or methods used in introducing it into the hole. If cement or other plugs were used, state the character of same and depth placed, from _____ feet to _____ feet for each plug set.

Plug back with sand to 3025', dump 5 sacks cement, pull 5 1/2" casing.

Mud hole to 275', set 10' rock bridge, mix and dump 20 sacks cement,

fill hole with mud to 35' of base of cellar, set 5' rock bridge, mix and

put in 5 sacks cement.

(If additional description is necessary, use BACK of this sheet)

Name of Plugging Contractor Ace pipe Pulling Co.
Address Box 304, Great Bend, Kansas

STATE OF Kansas, COUNTY OF Barton, ss.
Frank G. Wood (owner or operator) of the above-described

well, being first duly sworn on oath, says: That I have knowledge of the facts, statements, and matters herein contained and the log of the above-described well as filed and that the same are true and correct. So help me God.

(Signature) Frank G. Wood

Great Bend, Kansas
(Address)

SUBSCRIBED AND SWORN TO before me this 20th day of December, 19 55

Dean Shober
Notary Public.

My commission expires April 29, 1957.

PLUGGING
FILE SEC 6 T 16 R 12 W
BOOK PAGE 20 LINE 35

12-23-55
Rusa

WEIL LOG
Staudinger #1
NE NE NE of 6-16-12W
Barton County, Kansas

Elevation 1841 KB
Anhydrite 776 (-1065)
Heebner 2928 (-1087)
Lansing 3024 (-1183)
Gorham Sand 3294 (-1453)

0-45	Clay and post rock
45-110	Clay, shale and sand
110-290	Shale and sand
290-463	Red clay and blue shale
463-490	Blue shale
490-776	Red bed
776-802	Anhydrite
802-1230	Shale and shells
1230-1390	Salt and shale
1390-1575	Shale and shells
1575-1775	Lime and shale
1775-1980	Broken lime
1980-2705	Lime and shale
2705-2885	Lime
2885-3020	Lime and shale
3020-3183	Lime
3183-3280	Lime
3280-3300	Conglomerate and sand
3300	TOTAL ROTARY DEPTH

A F F I D A V I T

STATE OF Kansas, COUNTY OF Barton, SS

I, Frank G. Wood, of the DUKE & WOOD DRILLING COMPANY, being first duly sworn on oath, state; That I have knowledge of the facts, statements and matters herein contained and that the same are true and correct.

Frank G. Wood
Partner

Subscribed and sworn to before me this 24th day of March, 1955.

Hewitt Coley
Notary Public

My commission expires: April 29, 1957.

PLUGGING

FILE SEC 6-T-16-R-12W
BOOK PAGE 20 LINE 35