


STATE OF KANSAS
STATE CORPORATION COMMISSION

Give All Information Completely
Make Required Affidavit
Mail or Deliver Report to:
Conservation Division
State Corporation Commission
211 No. Broadway
Wichita, Kansas

Form CP-4

15-009-15692-0001
WELL PLUGGING RECORD

NORTH

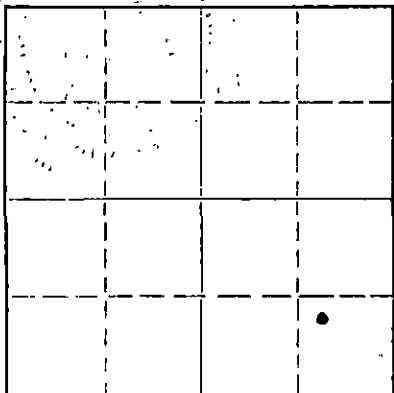

Locate well correctly on above
Section Plat

Barton County, Sec. 6 Twp. 16 Rge. 12 (W)
Location as "NE/CNW/SW" or footage from lines NW SE SE
Lease Owner National Cooperative Refinery Association
Lease Name NW Beaver Unit (Depiesse #6) Tr. 8 Well No. 6
Office Address Box 6, Great Bend, Kansas 67530
Character of Well (completed as Oil, Gas or Dry Hole) SWD
Date well completed 7-21 19 49
Application for plugging filed 1-12 19 76
Application for plugging approved 1-13 19 76
Plugging commenced 1-23 19 76
Plugging completed 1-23 19 76
Reason for abandonment of well or producing formation Unrecoverable
deteriorated tbq.
If a producing well is abandoned, date of last production 19
Was permission obtained from the Conservation Division or its agents before plugging was commenced? Yes

Name of Conservation Agent who supervised plugging of this well Duane Rankin
Producing formation Depth to top Bottom Total Depth of Well 3430 Feet
Show depth and thickness of all water, oil and gas formations.

OIL, GAS OR WATER RECORDS

CASING RECORD

FORMATION	CONTENT	FROM	TO	SIZE	PUT IN	PULLED OUT
				8 5/8"	501'	-0-
				5 1/2"	3280'	-0-

Describe in detail the manner in which the well was plugged, indicating where the mud fluid was placed and the method or methods used in introducing it into the hole. If cement or other plugs were used, state the character of same and depth placed, from feet to feet for each plug set.

Halliburton pumped 10 sx. cement, 10 sx. gel and 50 sx. cement.
1000# max. press. 300# SIP.

(If additional description is necessary, use BACK of this sheet)

Name of Plugging Contractor None
Address

STATE OF KANSAS, COUNTY OF BARTON, ss.

I. J. Gotsche

(employee of owner) or (owner or operator) of the above-described

well, being first duly sworn on oath, says: That I have knowledge of the facts, statements and matters herein contained and the log of the above-described well as filed and that the same are true and correct. So help me God.

(Signature)

I. J. Gotsche

Box 6, Great Bend, Kansas 67530

(Address)

SUBSCRIBER AND SWORN TO before me this 28th day of January, 1976

Patricia Bradley
Patricia Bradley

Notary Public.

My commission expires Jan. 29, 1977

DRILLER'S LOG

#6 DEPIESSE
Franco Central Oil Co.

NW SE SE Sec. 6-16-12W
Barton County, Kansas

Contractor: Phillips & Hanson

Elevation: 1841'

Comm: 7-10-49

Comp: 7-22-49

clay, sand & rock	30
shale & sand	380
shale & shells	482
red rock	787
anhydrite	815
shale & shells	1430
lime & shale	1560
lime	1660
lime & shale	1800
lime	2040
lime & shale	2275
shale, lime & shells	2330
lime & shale	2610
lime	2975
lime & shale	3015
lime	3053
lime (hard)	3095
lime	3281

T.D.

8 5/8" set at 501' w/250 sacks cement.
5 1/2" set at 3281' w/100 sacks cement.

RECEIVED
STATE CORPORATION COMMISSION

JAN 13 1976

CONSERVATION DIVISION
Wichita, Kansas

STATE OF KANSAS)
) SS
SEDGWICK COUNTY)

We hereby certify that the above is a true and correct copy
of the driller's log of the #6 Depiesse, located in the NW SE SE of
Section 6-16-12W, Barton County, Kansas.

PHILLIPS & HANSON

By Harry L. Hanson

Subscribed and sworn to before me, this 15th day of August, 1949.

Wella A. Hunsberg
Notary Public

My com. expires Oct. 4, 1949.