


Give All Information Completely  
Make Required Affidavit  
Mail or Deliver Report to:  
Conservation Division  
State Corporation Commission  
211 No. Broadway  
Wichita, Kansas

WELL PLUGGING RECORD

NORTH

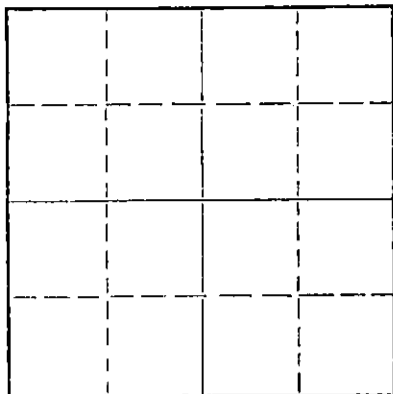

Locate well correctly on above  
Section Flat

Hodgeman County. Sec. 13 Twp. 21 Rge. (E) 24 (W)  
Location as "NE/CNW%SW%" or footage from lines C SE SW  
Lease Owner Pickrell Drilling Company  
Lease Name Goebel "A" Well No. 2  
Office Address 705 4th Natl Bank Bldg, Wichita 2, Kansas  
Character of Well (completed as Oil, Gas or Dry Hole) Dry Hole  
Date well completed January 9, 19.64  
Application for plugging filed January 9, 19.64  
Application for plugging approved January 9, 19.64  
Plugging commenced January 9, 19.64  
Plugging completed January 9, 19.64  
Reason for abandonment of well or producing formation Dry Hole

If a producing well is abandoned, date of last production 19  
Was permission obtained from the Conservation Division or its agents before plugging was commenced? Yes

Name of Conservation Agent who supervised plugging of this well Frank Broadfoot  
Producing formation \_\_\_\_\_ Depth to top \_\_\_\_\_ Bottom \_\_\_\_\_ Total Depth of Well 4565 Feet  
Show depth and thickness of all water, oil and gas formations.

OIL, GAS OR WATER RECORDS

CASING RECORD

FORMATION	CONTENT	FROM	TO	SIZE	PUT IN	PULLED OUT
				8 5/8	272'	None

Describe in detail the manner in which the well was plugged, indicating where the mud fluid was placed and the method or methods used in introducing it into the hole. If cement or other plugs were used, state the character of same and depth placed, from \_\_\_\_\_ feet to \_\_\_\_\_ feet for each plug set.

Heavy mud to 240'. Set plug. Cemented with 25 sacks cement. Heavy mud to 40'. Set plug, cemented with 15 sacks cement to bottom of cellar. Plugged rat hole with 2 sacks cement.

RECEIVED  
STATE CORPORATION COMMISSION

JAN 29 1964  
1-29-64  
CONSERVATION DIVISION  
Wichita, Kansas

(If additional description is necessary, use BACK of this sheet)

Name of Plugging Contractor Pickrell Drilling Company  
Address 705 4th National Bank Building, Wichita 2, Kansas

STATE OF KANSAS, COUNTY OF KINGMAN, ss.  
C. W. SEBITS (owner or operator) of the above-described well, being first duly sworn on oath, says: That I have knowledge of the facts, statements, and matters herein contained and the log of the above-described well as filed and that the same are true and correct. So help me God.

(Signature) C. W. Sebitt  
C. W. Sebitt  
705 4th National Bank Bldg, Wichita 2, Kansas  
(Address)

SUBSCRIBED AND SWORN TO before me this 13th day of January, 19 64

Maxine Blackman  
Maxine Blackman  
Notary Public.

My commission expires June 21, 1966

**ROTARY DRILLING LOG**

COMPANY: PICKRELL DRILLING COMPANY  
705 4th National Bank Building  
Wichita 2, Kansas

Rotary Drilling Commenced 12-27-63

Rotary Drilling Completed 1--8-64

LOCATION: Goebel "A" No. 2 -- C SE SW Section 13-21-24W, Hodgeman County, Kansas

CONTRACTOR: **PICKRELL DRILLING COMPANY**  
Wichita, Kansas

CASING RECORD: (12 jts) 272' 8 5/8" surface casing set at 271' KB. Cemented with 175 sacks cement. Circulated. Completed 4:00 P.M. December 27, 1963. No oil string run. D & A.

**LOG**

(Figures indicate bottom of formation — measurements from top of rotary bushing.)

60	Sand	<u>C. F. S.</u>
140	Shale & Shells	4410
425	Shale	4424
700	Shale & Shells	4492
975	Red Beds	4502
990	Blaine	4508
1050	Shale & Shells	4513
1275	Sand	4523
1590	Shale & Shells, Red Bed	4539
1635	Anhydrite	4545
2140	Shale & Shells	4565
2575	Lime & Shale	
2777	Lime	<u>Slope Tests</u>
3535	Lime & Shale	2500
3620	Sandy Lime & Shale	3000
3716	Lime & Shale	3500
3820	Sandy Lime & Shale	4100
3905	Lime & Shale	
4295	Lime	
4424	Lime & Shale	<u>S. L. M.</u>
4485	Lime	3672
4510	Lime & Shale	4040
4565	Mississippian - TD	4403

**RECEIVED**  
STATE CORPORATION COMMISSION

JAN 29 1964

CONSERVATION DIVISION  
Wichita, Kansas

The undersigned, C. W. SEBITS, Attorney-in-Fact for PICKRELL DRILLING COMPANY, hereby certifies in behalf of said Company, that the above is a true and correct log of the formation encountered in drilling the above well as reflected by the Daily Drilling Reports.

PICKRELL DRILLING COMPANY

By [Signature]  
C. W. SEBITS, Attorney-in-Fact

STATE OF KANSAS }  
COUNTY OF SEDGWICK } ss.:

On this 13th day of January, 1964, before me the undersigned, a Notary Public, in and for the County and State aforesaid, personally appeared C. W. Sebitts, to me known to be the identical person who subscribed the name of PICKRELL DRILLING COMPANY to the foregoing instrument as its Attorney-in-Fact and acknowledged to me that he executed the same as his free and voluntary act and deed, and as the free and voluntary act and deed of such company, for the uses and purposes therein set forth.

Given under my hand and seal of office the day and year last above written.

My commission expires: June 21, 1966

[Signature]  
Maxine Blackman Notary Public